

CARD MUST BE TYPED

State of Kansas

CARD MUST BE SIGNED

NOTICE OF INTENTION TO DRILL

(see rules on reverse side)

Starting Date June 30, 1987
month day year

API Number 15- 163-22,934 00-00

OPERATOR: License # 5205 ~~5~~ 4254

SE. NW.. SE. Sec. 32.. Twp.. 8S S, Rg. 17W.. XX West

Name Mid-Continent Energy Corp. & Cross- 1650 Ft. from South Line of Section

Address 120 S. Market wind Petroleum Inc. 1650 Ft. from East Line of Section

City/State/Zip Wichita, KS 67202

(Note: Locate well on Section Plat on reverse side)

Contact Person Brad Buehler

Phone 265-9501

Nearest lease or unit boundary line 990 feet

CONTRACTOR: License # 6033

County Rooks

Name Murfin Drilling Company

Lease Name Lewis Well # A#1

City/State Wichita, KS

Ground surface elevation N/A feet MSL

Well Drilled For: Well Class: Type Equipment:

Domestic well within 330 feet: yes XX no

X Oil SWD Infield XX Mud Rotary

Municipal well within one mile: yes XX no

Gas Inj Pool Ext Air Rotary

Surface pipe by Alternate: 1 2 X

OWWO Expl XX Wildcat Cable

Depth to bottom of fresh water 100

If OWWO: old well info as follows:

Depth to bottom of usable water 700 800

Operator

Surface pipe planned to be set 200

Well Name

Projected Total Depth 3450 feet

Comp Date Old Total Depth

Formation Arbuckle

I certify that well will comply with K.S.A. 55-101, et seq., plus eventually plugging hole to KCC specifications.

cementing will be done immediately upon setting production casing.

Date 6/23/87 Signature of Operator or Agent [Signature] Title President

For KCC Use:

Conductor Pipe Required feet; Minimum Surface Pipe Required 200 feet per Alt. X (2)


This Authorization Expires 6-26-87 Approved By [Signature] 6-26-87

Must be filed with the K.C.C. five (5) days prior to commencing well
This card void if drilling not started within six (6) months of date received by K.C.C.

Important procedures to follow:

1. Notify District office before setting surface casing.
2. Set surface casing by circulating cement to the top.
3. File completion forms ACO-1 with K.C.C. within 90 days of well completion, following instructions on ACO-1, side 1, and including copies of wireline logs.
4. Notify District office 48 hours prior to old well workover or re-entry.
5. Prior to filing Intent, prepare a proposed plugging plan in case well is D & A, then obtain approval of plan when calling district office prior to setting surface pipe.
6. Submit plugging report (CP-4) to K. C. C. after plugging is completed.
7. Obtain an approved injection docket number before disposing of salt water.
8. Notify K.C.C. within 10 days when injection commences or terminates.
9. If an alternate 2 completion, cement in the production pipe from below any usable water to surface within 120 days of spud date.

A Regular Section of Land 1 Mile = 5,280 Ft.

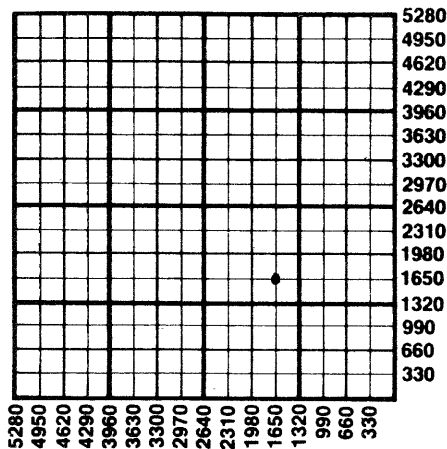

STATE CORPORATION COMMISSION

JUN 25 1987 6/25/87

State Corporation Commission of Kansas
Conservation Division
200 Colorado Derby Building
Wichita, Kansas 67202
(316) 263-3238