

FOR KCC USE:

FORM C-1 7/91

FORM MUST BE TYPED

FORM MUST BE SIGNED

ALL BLANKS MUST BE FILLED

EFFECTIVE DATE: 7-3-96

State of Kansas

DISTRICT # 4

NOTICE OF INTENTION TO DRILL

SGA? ... Yes ... No

Must be approved by the K.C.C. five (5) days prior to commencing well.

Expected Spud Date 8 month 28 day 96 year

Spot APPROX. SW- SE- NE- Sec 32 Twp 8 S, Rg 17 East West

OPERATOR: License # 3218  
Name: American Trading & Production Corp.  
Address: 7676 Hillmont, Ste. 350  
City/State/Zip: Houston, Texas 77040  
Contact Person: Donald W. Garrett  
Phone: (713) 460-2355

2300 feet from South / (North) line of Section  
1130 feet from (East) / West line of Section  
IS SECTION X REGULAR IRREGULAR?

(NOTE: Locate well on the Section Plat on Reverse Side)  
County: Rooks

Lease Name: Stamper, E Well #: 8  
Field Name: Dopita

Is this a Prorated/Spaced Field? ... yes X no  
Target Formation(s): Lansing - Kansas City

Nearest lease or unit boundary: 330  
Ground Surface Elevation: 1960 feet MSL

Water well within one-quarter mile: ... yes X no  
Public water supply well within one mile: ... yes X no

Depth to bottom of fresh water: 75 180  
Depth to bottom of usable water: 880 720

Surface Pipe by Alternate: X 1 2  
Length of Surface Pipe Planned to be set: 1300

Length of Conductor pipe required: None  
Projected Total Depth: 3450

Formation at Total Depth: Arbuckle  
Water Source for Drilling Operations:

... well X farm pond ... other

\* CONTRACTOR: License #: UNKNOWN  
Name: ADVISE ON ACO-1

Well Drilled For: Well Class: Type Equipment:  
X Oil X Enh Rec X Infield X Mud Rotary  
... Gas ... Storage ... Pool Ext. ... Air Rotary  
... OWWO ... Disposal ... Wildcat ... Cable  
... Seismic; ... # of Holes ... Other

If OWWO: old well information as follows:  
Operator: \_\_\_\_\_  
Well Name: \_\_\_\_\_  
Comp. Date: \_\_\_\_\_ Old Total Depth \_\_\_\_\_

Directional, Deviated or Horizontal wellbore? ... yes X no

If yes, true vertical depth: \_\_\_\_\_

Bottom Hole Location: \_\_\_\_\_

Will Cores Be Taken? ... yes X no

If yes, proposed zone: \_\_\_\_\_

AFFIDAVIT

The undersigned hereby affirms that the drilling, completion and eventual plugging of this well will comply with K.S.A. 55-101, et. seq.

It is agreed that the following minimum requirements will be met:

1. Notify the appropriate district office prior to spudding of well;
2. A copy of the approved notice of intent to drill shall be posted on each drilling rig;
3. The minimum amount of surface pipe as specified below shall be set by circulating cement to the top; in all cases surface pipe shall be set through all unconsolidated materials plus a minimum of 20 feet into the underlying formation;
4. If the well is dry hole, an agreement between the operator and the district office on plug length and placement is necessary prior to plugging;
5. The appropriate district office will be notified before well is either plugged or production casing is cemented in;
6. IF AN ALTERNATE II COMPLETION, PRODUCTION PIPE SHALL BE CEMENTED FROM BELOW ANY USABLE WATER TO SURFACE WITHIN 120 DAYS OF SPUD DATE. IN ALL CASES, NOTIFY DISTRICT OFFICE PRIOR TO ANY CEMENTING.

I hereby certify that the statements made herein are true and to the best of my knowledge and belief.

Date: 6-25-96 Signature of Operator or Agent: [Signature] Title: Operations Manager

FOR KCC USE:  
 API # 15- 163-237830000  
 Conductor pipe required NONE feet  
 Minimum surface pipe required 740 feet per Alt. (1) X  
 Approved by: [Signature] 6-28-96  
 This authorization expires: 12-28-96  
 (This authorization void if drilling not started within 6 months of effective date.)  
 Spud date: \_\_\_\_\_ Agent: \_\_\_\_\_

REMEMBER TO:

- File Drill Pit Application (form CDP-1) with Intent to Drill;
- File Completion Form ACO-1 within 120 days of spud date;
- File acreage attribution plat according to field proration orders;
- Notify appropriate district office 48 hours prior to workover or re-entry;
- Submit plugging report (CP-4) after plugging is completed;
- Obtain written approval before disposing or injecting salt water.

Mail to: KCC - Conservation Division, 130 S. Market - Room 2078, Wichita, Kansas 67202.

RECEIVED  
6/28/96  
JUN 28 1996

3X  
8  
173

**IN ALL CASES PLOT THE INTENDED WELL ON THE PLAT BELOW**

**PLAT OF ACREAGE ATTRIBUTABLE TO A WELL IN A PRORATED OR SPACED FIELD**

If the intended well is in a prorated or spaced field, please fully complete this side of the form. If the intended well is in a prorated or spaced field complete the plat below showing that the well will be properly located in relationship to other wells producing from the common source of supply. Please show all the wells within 1 mile of the boundaries of the proposed acreage attribution unit for gas wells and within 1/2 mile of the boundaries of the proposed acreage attribution unit for oil wells.

API NO. 15- \_\_\_\_\_

OPERATOR \_\_\_\_\_

LEASE \_\_\_\_\_

WELL NUMBER \_\_\_\_\_

FIELD \_\_\_\_\_

LOCATION OF WELL: COUNTY \_\_\_\_\_

\_\_\_\_\_ feet from south/north line of section

\_\_\_\_\_ feet from east/west line of section

SECTION \_\_\_\_\_ TWP \_\_\_\_\_ RG \_\_\_\_\_

NUMBER OF ACRES ATTRIBUTABLE TO WELL \_\_\_\_\_

QTR/QTR/QTR OF ACREAGE \_\_\_\_\_ - \_\_\_\_\_ - \_\_\_\_\_



IS SECTION \_\_\_\_\_ REGULAR or \_\_\_\_\_ IRREGULAR

**IF SECTION IS IRREGULAR, LOCATE WELL FROM NEAREST CORNER BOUNDARY.**

Section corner used: \_\_\_\_\_ NE \_\_\_\_\_ NW \_\_\_\_\_ SE \_\_\_\_\_ SW

**PLAT**

(Show location of the well and shade attributable acreage for prorated or spaced wells.)  
 (Show footage to the nearest lease or unit boundary line.)

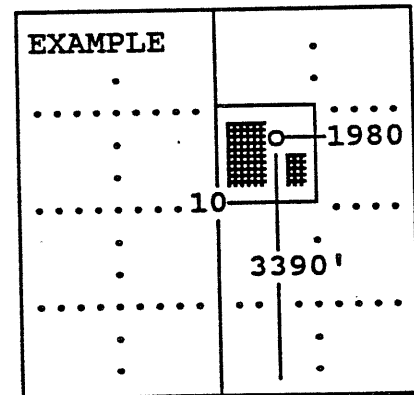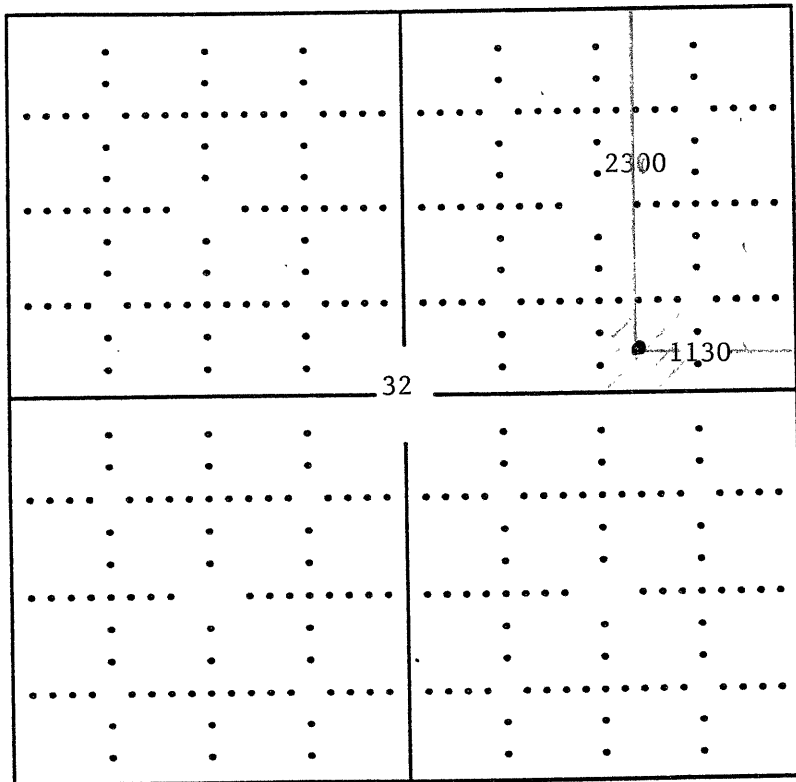

SEWARD CO.

Rooks Co.

**In plotting the proposed location of the well, you must show:**

- 1) The manner in which you are using the depicted plat by identifying section lines, i.e. 1 section, 1 section with 8 surrounding sections, 4 sections, etc.;
- 2) the distance of the proposed drilling location from the section's south/north and east/west; and
- 3) the distance to the nearest lease or unit boundary line.