

15-163-30196-00-00 A


STATE OF KANSAS  
STATE CORPORATION COMMISSION

Form CP-4

Give All Information Completely  
Make Required Affidavit  
Mail or Deliver Report to:  
Conservation Division  
State Corporation Commission  
212 No. Market  
Wichita, Kansas

WELL PLUGGING RECORD

NORTH

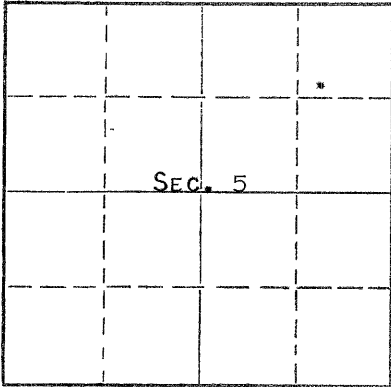

Locate well correctly on above  
Section Plat

ROOKS County. Sec. 5 Twp. 9s Rge. 18 (E) (W)  
Location as "NE/CNW%SW%" or footage from lines SW NE NE  
Lease Owner PETROLEUM, INC.,  
Lease Name MEISTRELL "E" Well No. 1  
Office Address R.R. #2, GREAT BEND, KANSAS  
Character of Well (completed as Oil, Gas or Dry Hole) DRY HOLE  
Date well completed AUG. 26 19 66  
Application for plugging filed AUG. 26 19 66  
Application for plugging approved AUG. 26 19 66  
Plugging commenced AUG. 26 19 66  
Plugging completed AUG. 26 19 66  
Reason for abandonment of well or producing formation NO PRODUCTIBLE ZONES

If a producing well is abandoned, date of last production NONE 19  
Was permission obtained from the Conservation Division or its agents before plugging was commenced? YES

Name of Conservation Agent who supervised plugging of this well LEO F. MASSEY  
Producing formation \_\_\_\_\_ Depth to top \_\_\_\_\_ Bottom \_\_\_\_\_ Total Depth of Well 3478<sup>+</sup> Feet  
Show depth and thickness of all water, oil and gas formations.

OIL, GAS OR WATER RECORDS

CASING RECORD

FORMATION	CONTENT	FROM	TO	SIZE	PUT IN	PULLED OUT
				8-5/8"	214 <sup>+</sup>	NONE

Describe in detail the manner in which the well was plugged, indicating where the mud fluid was placed and the method or methods used in introducing it into the hole. If cement or other plugs were used, state the character of same and depth placed, from \_\_\_\_\_ feet to \_\_\_\_\_ feet for each plug set.

MUDDERED UP WITH MUD TO 540<sup>+</sup>, FOLLOWED BY WOODEN PLUG, PLACED 1/2 SACK HULLS AND 20 SACKS CEMENT THRU DRILL PIPE ON TOP OF PLUG. MUDDERED UP WITH HEAVY MUD TO 210<sup>+</sup>, FOLLOWED BY WOODEN PLUG, PLACED 20 SACKS CEMENT ON TOP OF PLUG. MUDDERED UP WITH HEAVY MUD TO 40<sup>+</sup>, FOLLOWED BY WOODEN PLUG, PLACED 10 SACKS CEMENT ON TOP OF PLUG TO BASE OF WELL CELLAR.

RECEIVED  
SEP 14 1966  
CONSERVATION DIVISION  
Wichita, Kansas

(If additional description is necessary, use BACK of this sheet)

Name of Plugging Contractor GARVEY DRILLING COMPANY  
Address R.R. #2, GREAT BEND, KANSAS

STATE OF KANSAS, COUNTY OF BARTON, ss.  
MONTE CHADD, DIST. PROD. SUPT. (employee of owner) or (owner or operator) of the above-described well, being first duly sworn on oath, says: That I have knowledge of the facts, statements, and matters herein contained and the log of the above-described well as filed and that the same are true and correct. So help me God.  
(Signature) *Monte Chadd*  
(Address) \_\_\_\_\_

SUBSCRIBED AND SWORN TO before me this 13 day of SEPTEMBER, 1966

My commission expires MAY 28, 1969

*Richard H. Dumbler*  
Notary Public.

15-163-30196-00-00

# WELL LOG

COMPANY Petroleum, Inc.

SEC. 5 T. 9S R. 18W

FARM Meistrel NO. E-1

LOC. SW NE NE

TOTAL DEPTH 3478'

COUNTY Rooks

COMM. 8-18-66 COMP. 8-26-66

CONTRACTOR Garvey Drilling Company


CASING 8 5/8" @ 214' w/160 sx

ELEVATION 2027' KB

PRODUCTION D & A

FIGURES INDICATE BOTTOM OF FORMATIONS

- 30' Clay and Post Rock
- 75' Shale and Sand
- 915' Shale
- 1040' Sand
- 1275' Sand and Shale
- 1640' Red Bed and Shale
- 2030' Shale and Shells
- 2215' Shale and Lime
- 2525' Lime and Shale
- 2575' Shale and Lime
- 2970' Lime and Shale
- 3120' Shale and Lime
- 3185' Lime and Shale
- 3478' Lime
- 3478' RTD

**RECEIVED**  
 STATE CORPORATORY COMMISSION  
 9/14/66  
 SEP 14 1966  
 CONSERVATION DIVISION  
 Topeka, Kansas

State of Kansas }  
 County of Barton } SS

I, Sam N. Stephens of Garvey Drilling Company

upon oath state the above and foregoing is a true and correct copy of the log of the Meistrel E-1 well.

*Sam N. Stephens*

Subscribed and sworn to before me this 13th day of September 19 66

My Commission Expires: November 5, 1969

*Richard Boep*  
 NOTARY PUBLIC