


15-163-03351-00-00

STATE OF KANSAS  
STATE CORPORATION COMMISSION

WELL PLUGGING RECORD

Give All Information Completely  
Make Required Affidavit  
Mail or Deliver Report to:  
Conservation Division  
State Corporation Commission  
800 Bittling Building  
Wichita, Kansas

Rooks County. Sec. 5 Twp. 9s Rge. 18W (E) (W)  
Location as "NE/CNW/SW" or footage from lines SW NW NW  
Lease Owner Lawrence Supply Company  
Lease Name Holmes Well No. 2  
Office Address Box 448 - Great Bend, Kansas  
Character of Well (completed as Oil, Gas or Dry Hole) Oil well  
Date well completed December 16 19 48  
Application for plugging filed August 3 19 54  
Application for plugging approved August 5 19 54  
Plugging commenced August 11 19 54  
Plugging completed August 14 19 54  
Reason for abandonment of well or producing formation Ceased production

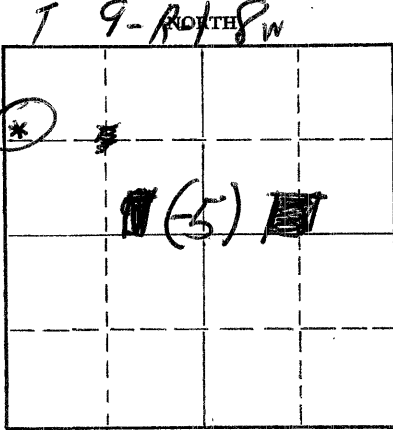

Locate well correctly on above  
Section Plat

If a producing well is abandoned, date of last production April 19 54  
Was permission obtained from the Conservation Division or its agents before plugging was commenced? Yes

Name of Conservation Agent who supervised plugging of this well Eldon Petty  
Producing formation Arbuckle Depth to top 3496' Bottom 4' Total Depth of Well 3500 Feet  
Show depth and thickness of all water, oil and gas formations.

OIL, GAS OR WATER RECORDS

CASING RECORD

FORMATION	CONTENT	FROM	TO	SIZE	PUT IN	PULLED OUT
				10-3/4"	193'	None
				5-1/2"	3496'	2209'

Describe in detail the manner in which the well was plugged, indicating where the mud fluid was placed and the method or methods used in introducing it into the hole. If cement or other plugs were used, state the character of same and depth placed, from \_\_\_\_\_ feet to \_\_\_\_\_ feet for each plug set.

Filled hole with sand from 3500' to 3490' and ran 4 sacks of cement. Mudded hole to 193', set a 10' rock bridge and ran 15 sacks of cement. Mudded hole to 35', set a 10' rock bridge and ran 10 sacks of cement on top. Plugging completed.

(If additional description is necessary, use BACK of this sheet)

Name of Plugging Contractor West Supply Co., Inc.  
Address Chase, Kansas

STATE OF Kansas, COUNTY OF Rice, ss.  
L. B. Lawrence (employee of owner) or (owner or operator) of the above-described well, being first duly sworn on oath, says: That I have knowledge of the facts, statements, and matters herein contained and the log of the above-described well as filed and that the same are true and correct. So help me God. LAWRENCE SUPPLY CO.

(Signature) L. B. Lawrence  
Great Bend, Kansas  
(Address)

SUBSCRIBED AND SWORN TO before me this 20th day of August, 19 54

Edward E. Abram  
Notary Public.

My commission expires May 20, 1957

Received  
9/27/54

PLUGGING  
SEC 5 T 9 R 18W  
PAGE 53 LINE 35

15-163-03351-30-00


WELL LOG BUREAU - KANSAS GEOLOGICAL SOCIETY  
412 Union National Bk. Bldg., Wichita, Kansas

Company - ATLANTIC REFG. CO.  
Farm - Holmes No. 2

SEC. 5 T. 9 R. 18W  
SW NW NW

Total Depth. 3500'  
Comm. 11-30-48 Comp. 12-16-48  
Shot or Treated. Acidized  
Contractor. Loman-Johnson Drlg. Co.  
Issued. 2-5-49

County. Rocks  
KANSAS

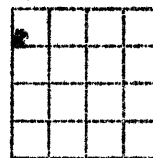

Elevation. \_\_\_\_\_

Production. Pot. 220 BO

Figures Indicate Bottom of Formations.

surface clay	85
sand & shale	290
shale	670
sand & shale	755
shale & sand	1170
shale	1445
lime	1475
lime & shale	1840
lime	2178
shale & lime	2226
lime	2353
lime & shale	2430
lime	2545
lime & shale	2655
lime	2830
lime & shale	2995
lime	3123
lime & shale	3284
lime	3315
lime & shale	3494
arbutcke lime	3500
Total Depth	

Tops:  
Lansing 3238  
Arbutcke 3494 RB

Drilled out to T. D. Washed w/1  
barrel acid & swabbed 2 1/2 to 3 30PH

On state pot. test 1-14-49, tested  
220 BOPD.

Daily allowable 25 BOPD effective 12-21-48

Producing Area: 3496-3500'

9/27/54

