

15-163-00875-00-00

STATE OF KANSAS
STATE CORPORATION COMMISSION


WELL PLUGGING RECORD

Give All Information Completely
Make Required Affidavit
Mail or Deliver Report to:
Conservation Division
State Corporation Commission
800 Bitting Building
Wichita, Kansas

Rooks County. Sec. 5 Twp. 9 Rge. 18 (E) W (W)

Location as "NE/CNW/SW" or footage from lines SW SW NE
Lease Owner C-G Drilling Co. & Oil Trading Associates, Inc.
Lease Name Meistrell Well No. 1
Office Address 107 Rule Bldg., Wichita, Kansas
Character of Well (completed as Oil, Gas or Dry Hole) Dry Hole
Date well completed November 25 1955
Application for plugging filed November 25 1955
Application for plugging approved November 25 1955
Plugging commenced November 26 1955
Plugging completed November 26 1955
Reason for abandonment of well or producing formation Too Low structurally

NORTH

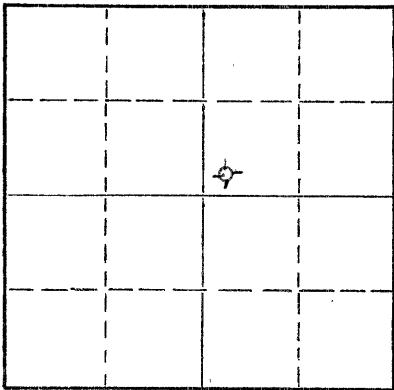

Locate well correctly on above
Section Plat

If a producing well is abandoned, date of last production 19
Was permission obtained from the Conservation Division or its agents before plugging was commenced? Yes

Name of Conservation Agent who supervised plugging of this well Eldon Petty, Hays, Kansas
Producing formation _____ Depth to top _____ Bottom _____ Total Depth of Well 3566 Feet
Show depth and thickness of all water, oil and gas formations.

OIL, GAS OR WATER RECORDS

CASING RECORD

FORMATION	CONTENT	FROM	TO	SIZE	PUT IN	PULLED OUT
				8-5/8"	191'	none

Describe in detail the manner in which the well was plugged, indicating where the mud fluid was placed and the method or methods used in introducing it into the hole. If cement or other plugs were used, state the character of same and depth placed, from _____ feet to _____ feet for each plug set.

Filled hole with heavy mud to 186'. Set plug. Put in 1/2 sack Hulls and 15 sacks of cement. Filled with heavy mud to 40'. Set plug. Filled to top with 1/2 sack Hulls and 10 sacks of cement.

(If additional description is necessary, use BACK of this sheet)

Name of Plugging Contractor C-G Drilling Co.
Address 107 Rule Bldg., Wichita, Kansas

STATE OF KANSAS, COUNTY OF SEDGWICK, ss.
Jay H. Galloway (employee of owner) or (owner or operator) of the above-described well, being first duly sworn on oath, says: That I have knowledge of the facts, statements, and matters herein contained and the log of the above-described well as filed and that the same are true and correct. So help me God.

(Signature) Jay H. Galloway
107 Rule Bldg.
(Address)

SUBSCRIBED AND SWORN TO before me this 29th day of November, 1955

Vicky Jacobs
Notary Public.

My commission expires May 20, 1959

PLUGGING
FILE REC 5-7-9-R 18W
BOOK PAGE 20 LINE 30

12/1/55
CONSERVATION DIVISION
WICHITA, KANSAS

15-163-00875-00-00

CONTRACTOR'S WELL LOG

OPERATOR C-G DRILLING CO. & OIL TRADING ASSOCIATES, INC WELL NAME MEISTRELL #1

LOCATION SW SW NE Sec. 5-9-18W

Rig #2

COUNTY ROOKS STATE KANSAS

COMMENCEMENT DATE NOVEMBER 17, 1955 COMPLETION DATE NOVEMBER 26, 1955

LOG OF WELL

Elevation 2056' rotary bushing.
All measurements from the top of rotary bushing.

FROM	mTO	FORMATION	DEVIATION FROM VERTICAL	REMARKS
0	186	Shale-Shells		
186	460	Shale		
460	690	Shale-Sand		
690	940	Shale-Shells		
940	1130	Sand		
1130	1370	Shale-Red Bed		
1370	1437	Shale		
1437	1478	Anhydrite		
1478	1910	Shale-Shells		
1910	2200	Shale-Lime		
2200	2367	Lime		
2367	2660	Lime-Shale	0° - 2500'	
2660	2895	Lime-Shale		
2895	3105	Lime-Shale	0° - 3000'	
3105	3238	Lime		
3238	3298	Lime		
3298	3340	Lime		
3340	3400	Lime		
3400	3482	Lime		
3482	3566	Lime	0° - 3500'	
	3566	TD		

CASING LEFT IN HOLE AFTER COMPLETION

191' of 8-5/8" OD Surface Casing.

STATE OF KANSAS, COUNTY OF SEDGWICK) ss.

The undersigned certifies that to the best of his knowledge and belief, the above facts are true and correct.

C-G DRILLING CO.

By Jay H. Galloway
Jay H. Galloway

Subscribed and sworn to before me this 29th day of November, 1955.

My commission expires:
May 20, 1959.

Vicky Jacobs
Vicky Jacobs, Notary Public

PLUGGING
WELL SEC 5-9-18W
WELL PAGE 20 LINE 30

Received
12/1/55