


STATE OF KANSAS  
STATE CORPORATION COMMISSION

WELL PLUGGING RECORD

Give All Information Completely  
Make Required Affidavit  
Mail or Deliver Report to  
Conservation Division  
State Corporation Comm.  
245 North Water  
Wichita, KS 67202

*Kca*  
Rooks County, Sec. 10 Twp. 9S Rge. 18 E/W  
Location as "NE/CNW $\frac{1}{4}$ SW $\frac{1}{4}$ " or footage from lines  
*120* 1650' FNL, 2310' FNL 2970' FEL  
Lease Owner Cities Service Oil Company  
Lease Name Meyers "F" Well No. 1  
Office Address 700 Sutton Pl., 209 E. William, Wichita, Ks.  
Character of Well (Completed as Oil, Gas or Dry Hole) \_\_\_\_\_  
Dry Hole  
Date Well completed 12-18-75 19  
Application for plugging filed 5-11-77 19  
Application for plugging approved 5-13-77 19  
Plugging commenced 5-18-77 19  
Plugging completed 5-18-77 19  
Reason for abandonment of well or producing formation \_\_\_\_\_

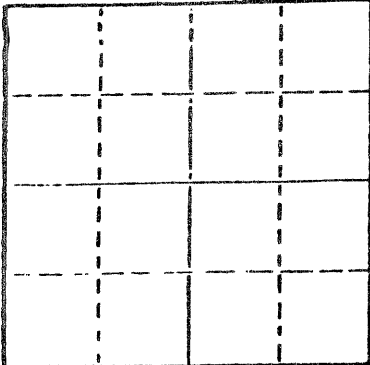

Locate well correctly on above  
Section Plat

If a producing well is abandoned, date of last production 19

Was permission obtained from the Conservation Division or its agents before plugging was commenced? Yes

Name of Conservation Agent who supervised plugging of this well Leo F. Massey  
Producing formation \_\_\_\_\_ Depth to top \_\_\_\_\_ Bottom \_\_\_\_\_ Total Depth of Well 3700  
Show depth and thickness of all water, oil and gas formations.

OIL, GAS OR WATER RECORDS

CASING RECORD

FORMATION	CONTENT	FROM	TO	SIZE	PUT IN	PULLED OUT
				8-5/8"	215'	Abandon
				5-1/2"	3570'	Abandon

Describe in detail the manner in which the well was plugged, indicating where the mud fluid was placed and the method or methods used in introducing it into the hold. If cement or other plugs were used, state the character of same and depth placed, from \_\_\_\_\_ feet to \_\_\_\_\_ feet for each plug set.

Cement 50 sacks 60-40 pozmix 3575-3700.  
30 sacks gel and 5 sacks hulls 600-3260' -- 5 1/2" plug, 75 sacks 60-40 pozmix  
3:00 PM 5-18-77

(If additional description is necessary, use BACK of this sheet)

Name of Plugging Contractor Halliburton Company

STATE OF Kansas COUNTY OF Sedgwick, ss.  
E. W. Peterman (employee of owner) or (owner or operator)  
of the above-described well, being first duly sworn on oath, says: That I have knowledge of the facts, statements, and matters herein contained and the log of the above-described well as filed and that the same are true and correct. So help me God.

Glenn E. Meier  
STATE NOTARY PUBLIC  
Sedgwick County, Kansas

(Signature) E. W. Peterman  
Cities Service Oil Company E. W. Peterman  
(Address)

SUBSCRIBED AND SWORN TO before me this 11th day of May, 19 77

Glenn E. Meier  
STATE CORPORATION NOTARY PUBLIC

My commission expires 6/3/77

JUN 02 1977  
6-2-77  
CONSERVATION DIVISION  
Wichita, Kansas

DRILLERS' WELL LOG

DATE COMMENCED: December 5, 1975  
DATE COMPLETED: December 18, 1975

Cities Service Oil Company  
MEYERS F-1  
NE SE NW of Sec 10-T9S-R18W  
Rooks County, Kansas

ELEVATION: 2014 K.B.

FORMATION TOPS

0 - 40'	Shale, Post Rock
40 - 600'	Shale, Clay and Sand Streaks
600 - 930'	Sand and Shale
930 - 1106'	Sand and Shells
1106 - 1387'	Shale and Red Bed
1387 - 1418'	Anhydrite
1418 - 1950'	Shale
1950 - 3030'	Lime and Shale
3030 - 3125'	Lime
3125 - 3158'	Lime and Shale
3158 - 3161'	Shale
3161 - 3180'	Lime and Shale
3180 - 3200'	Lime
3200 - 3449'	Lime and Shale
3449 - 3575'	Dolomite
	RTD

Anhydrite	1387
Topeka	2945
Heebner	3158
Toronto	3180
Lansing	3200
Arbuckle	3449
RTD	3575

SURFACE PIPE:  
Set 215' of new 8 5/8", 28#  
pipe w/150 sacks 50/50 Pozmix,  
2% cc.

PRODUCTION PIPE: Ran new 5 1/2",  
14# casing @ 3569 1/2 w/20 bbl  
salt water and 250 sacks 50/50  
Pozmix w/10% salt & 1/2% CFR2  
Plus 50 sacks Common w/10%  
salt & 1/2% CFR2.

RECEIVED  
STATE CORPORATION COMMISSION  
MAY 13 1977  
5-13-77  
CONSERVATION DIVISION  
Wichita, Kansas

A F F I D A V I T

STATE OF KANSAS }  
COUNTY OF BARTON } ss.

Wayne Dobbs, of lawful age, does swear and state that the facts and statements herein contained are true and correct to the best of his knowledge.

Wayne Dobbs

Subscribed and sworn to before me this 23rd day of December, 1975.

Dorothy M. Hague  
Notary Public

My Commission Expires: April 11, 1978