

ORIGINAL

SIDE ONE

STATE CORPORATION COMMISSION OF KANSAS
OIL & GAS CONSERVATION DIVISION
WELL COMPLETION FORM
ACO-1 WELL HISTORY
DESCRIPTION OF WELL AND LEASE

API NO. 15- 163-23,167-00-00

County ROOKS

C-N/2 NE NW Sec. 17 Twp. 9 Rge. 18 W ^{East} West

4950 Ft. North from Southeast Corner of Section

3300 Ft. West from Southeast Corner of Section
(NOTE: Locate well in section plat below.)

Lease Name STAHL (SWD) Well # #1

Field Name MCHALE

~~Producing~~ Formation Lower Arbuckle

Elevation: Ground 2079 KB 2084

Total Depth 3658 P8TD

Operator: License # 5635

Name: THE GENE BROWN COMPANY

Address P.O. DRAWER #220

City/State/Zip PLAINVILLE, KS 67663

Purchaser: Farmland

Operator Contact Person: TOM BROWN

Phone (913) 434 4811

Contractor: Name: RED TIGER DRILLING

License: 5302

Wellsite Geologist: Micheal A. Davignon

Designate Type of Completion

New Well Re-Entry Workover

Oil SWD Temp. Abd.

Gas Inj Delayed Comp.

Dry Other (Core, Water Supply, etc.)

If **OWO**: old well info as follows:

Operator: _____

Well Name: _____

Comp. Date _____ Old Total Depth _____

Drilling Method:

Mud Rotary Air Rotary Cable


4-26-91 5-1-91 5-17-91

Spud Date Date Reached TD Completion Date

RECEIVED

6-27-91
JUN 27 1991

CONSERVATION DIVISION
Wichita, Kansas

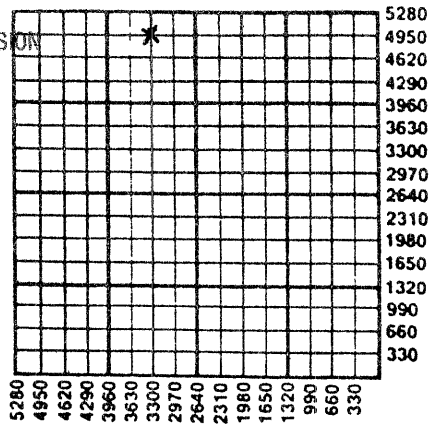

Amount of Surface Pipe Set and Cemented at 225 Feet

Multiple Stage Cementing Collar Used? Yes No

If yes, show depth set 1460 Feet

If Alternate II completion, cement circulated from 1460

feet depth to surface w/ 50 sks - 60/40 275 - lite sx cmt.

INSTRUCTIONS: This form shall be completed in triplicate and filed with the Kansas Corporation Commission, 200 Colorado Derby Building, Wichita, Kansas 67202, within 120 days of the spud date of any well. Rule 82-3-130, 82-3-107 and 82-3-106 apply. Information on side two of this form will be held confidential for a period of 12 months if requested in writing and submitted with the form. See rule 82-3-107 for confidentiality in excess of 12 months. One copy of all wireline logs and drillers time log shall be attached with this form. ALL CEMENTING TICKETS MUST BE ATTACHED. Submit CP-4 form with all plugged wells. Submit CP-111 form with all temporarily abandoned wells. Any recompletion, workover or conversion of a well requires filing of ACO-2 within 120 days from commencement date of such work.

All requirements of the statutes, rules and regulations promulgated to regulate the oil and gas industry have been fully complied with and the statements herein are complete and correct to the best of my knowledge.

Signature Thomas M. Brown

Title Development Supervisor Date 6-19-91

Subscribed and sworn to before me this 19th day of June, 1991.

Notary Public Kathy O. Wise

Date Commission Expires May 27, 1994

NOTARY PUBLIC - State of Kansas
KATHY A. WISE
My Appt. Exp. 5-27-94

K.C.C. OFFICE USE ONLY
F Letter of Confidentiality Attached
C Wireline Log Received 24 U2C
C Drillers Timelog Received 24 U2C

Distribution
 KCC SWD/Rep NGPA
 KGS Plug Other
(Specify)

