

STATE OF KANSAS STATE CORPORATION COMMISSION

WELL PLUGGING RECORD

Give All Information Completely Make Required Affidavit Mail or Deliver Report to Conservation Division State Corporation Comm. 245 North Water Wichita, KS 67202

Rooks County Sec. 17 Twp. 9s Rge. 18 NE/W Location as "NE/CNW/SW" or footage from lines SE SE NW

Lease Owner Griggs Oil Inc.

Lease Name Stahl Well No. 5

Office Address 1625 KSB & T Bldg. Wichita, KS 67202

Character of Well (Completed as Oil, Gas or Dry Hole)

Dry Hole

Date Well completed May 20, 19 81

Application for plugging filed May 20 19 81

Application for plugging approved May 20 19 81

Plugging commenced 4:00 P.M. May 20 19 81

Plugging completed 5:15 P.M. May 20 19 81


Reason for abandonment of well or producing formation No Commercial Production

If a producing well is abandoned, date of last production 19

Was permission obtained from the Conservation Division or its agents before plugging was commenced? yes

Name of Conservation Agent who supervised plugging of this well Marion Schmidt Producing formation Depth to top Bottom Tl. Depth of Well

Show depth and thickness of all water, oil and gas formations.

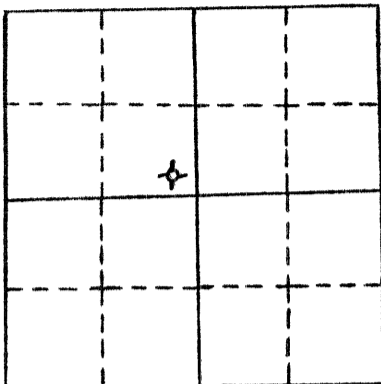

locate well correctly on above Section Plot

OIL, GAS OR WATER RECORDS

CASING RECORD

Table with 7 columns: FORMATION, CONTENT, FROM, TO, SIZE, PUT IN, PULLED OUT. Row 1: surface casing, common, 0', 249.25', 8 5/8", 249.25', 0'

Describe in detail the manner in which the well was plugged, indicating where the mud fluid was placed and the method or methods used in introducing it into the hold. If cement or other plugs were used, state the character of same and depth placed, from feet to feet for each plug set.

Plug #1 @ 780 ' with 65 sxs

Plug #2 @ 240' with 30 sxs

Plug #3 @ 40' with 10 sxs

5 sxs in rathole

Total 110 sxs 50-50 poz 6% gel

P.D. @ 5:15 P.M. 5-20-81

RECEIVED STATE CORPORATION COMMISSION 6-8-81 JUN - 8 1981

CONSERVATION DIVISION Wichita, Kansas

(If additional description is necessary, use BACK of this sheet)

Name of Plugging Contractor Pioneer Drilling Company, Inc. 308 West Mill Plainville, KS 67663

STATE OF Kansas COUNTY OF Sedgwick, ss.

Carole A. Neal (employee of owner) or (owner/operator) of the above described well, being first duly sworn on oath, says: That I have knowledge of the facts, statements, and matters herein contained and the log of the above described well is filed and that the same are true and correct. So help me God.

(Signature)

Carole A. Neal

(Address)

Carole A. Neal, Corporate Secretary 1625 Kansas State Bank Bldg. Wichita, Kansas 78202

SUBSCRIBED AND SWORN TO before me this 2nd day of June, 19 81

My commission expires



Marion R. Rivera Notary Public

JUN 1 1981

W E L L L O G

OPERATOR: Griggs Oil Inc.

WELL NAME: Stahl #5 LOCATION: SE SE NW 17-9s-18W

COUNTY: Rooks STATE: Kansas

WELL COMMENCED: May 11, 1981 WELL COMPLETED: May 20, 1981

ELEVATION: 2111' K.B. TOTAL DEPTH: 3582'

PRODUCTION: D & A RIG NO: #4

CASING - 8 5/8": 249.25' 1Jt. 28# used 6Jts. 24# new cemented with 160 sxs common 3% cc
2% gel did circ P.D. 5-11-81
 5 1/2": _____

ALL MEASUREMENTS TAKEN FROM THE TOP OF ROTARY BUSHING:


FROM	TO	FORMATION	DEVIATION FROM VERTICAL	REMARKS:
0'	259'	sand and shale	259' - 1/4 - degree	
259'	710'	shale and sand		
710'	1471'	shale and sand		
1471'	1513'	Anhydrite		
1513'	1556'	shales		
1556'	1779'	shales	1779' - 1 - degree	
1779'	1928'	shales		
1928'	2247'	shales		
2247'	2538'	shale		
2538'	2777'	shale		
2777'	2960'	shales		
2960'	3135'	shale and lime		
3135'	3187'	shale and lime	3163' - 2 - degree	
3187'	3300'	lime and shale		
3300'	3392'	shale and lime		
3392'	3449'	lime and shale		
3449'	3483'	shale and lime		
3483'	3539'	shale and lime		
3539'	3543'	Arbuckle		
3543'	3547'			
3547'	3549'	lime and shale		
3549'	3552'	Arbuckle		
3552'	3582'	lime and shale		
3582'	RTD			

RECEIVED
STATE CORPORATION COMMISSION

JUN - 8 1981
6-8-81
CONSERVATION DIVISION
Wichita, Kansas

STATE OF KANSAS
COUNTY OF _____

The undersigned hereby certifies that to the best of his knowledge and belief, the above facts are true and correct

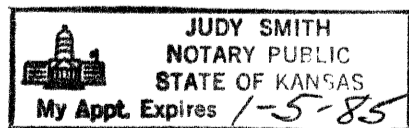

PIONEER DRILLING CO., INC.

By Cornelius Austin

SUBSCRIBED AND SWORN TO, BEFORE ME, This 29th day of May, 1981

Judy Smith
NOTARY PUBLIC