

STATE OF KANSAS  
STATE CORPORATION COMMISSION


Give All Information Completely  
Make Required Affidavit  
Mail or Deliver Report to:  
Conservation Division  
State Corporation Commission  
800 Bittling Building  
Wichita, Kansas

WELL PLUGGING RECORD

Rooks County, Sec. 17 Twp. 9S Rge. 18W (W)

Location as "NE/CNW/SW" or footage from lines NE NE NW  
Lease Owner Sinclair Oil & Gas Company  
Lease Name W. P. Stahl Well No. 1  
Office Address P. O. Box 521, Tulsa, Oklahoma  
Character of Well (completed as Oil, Gas or Dry Hole) Oil  
Date well completed October 6, 19 48  
Application for plugging filed September 15, 19 55  
Application for plugging approved September 16, 19 55  
Plugging commenced October 4, 19 55  
Plugging completed October 8, 19 55  
Reason for abandonment of well or producing formation Oil depleted.

NORTH

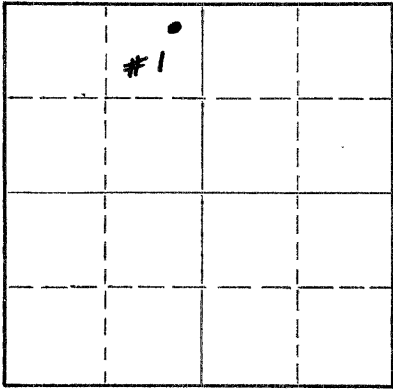

Locate well correctly on above  
Section Plat

If a producing well is abandoned, date of last production June 12, 19 53  
Was permission obtained from the Conservation Division or its agents before plugging was commenced? Yes

Name of Conservation Agent who supervised plugging of this well Mr. Eldon Petty  
Producing formation Arbuckle Depth to top 3495 Bottom 3504 Total Depth of Well 3504 Feet  
Show depth and thickness of all water, oil and gas formations.

OIL, GAS OR WATER RECORDS

CASING RECORD

FORMATION	CONTENT	FROM	TO	SIZE	PUT IN	PULLED OUT
Arbuckle Lime	Depleted	3495	3504	8-5/8"	278'	None
				5-1/2"	3496'	2033'

Describe in detail the manner in which the well was plugged, indicating where the mud fluid was placed and the method or methods used in introducing it into the hole. If cement or other plugs were used, state the character of same and depth placed, from \_\_\_\_\_ feet to \_\_\_\_\_ feet for each plug set.

Drilled out bridge at 1700'.  
Cleaned out to 3504' TD  
Filled hole with sand from 3504' to 3490'.  
Cemented from 3490' to 3455'.  
Mudded from 3455' to 307'.  
Rock bridge from 307' to 297'.  
Cemented from 297' to 267'.  
Mudded from 267' to 35'.  
Rock bridge 35' to 25'.  
Cemented from 25' to 0'.  
Welded cap on surface casing.

11-9-55

(If additional description is necessary, use BACK of this sheet)  
Name of Plugging Contractor West Supply Company  
Address Chase, Kansas.

STATE OF Kansas, COUNTY OF Rice, ss. W. B. Rhees

(employee of owner) or (owner or operator) of the above-described well, being first duly sworn on oath, says: That I have knowledge of the facts, statements, and matters herein contained and the log of the above-described well as filed and that the same are true and correct. So help me God.

(Signature) W. B. Rhees  
Chase, Kansas  
(Address)

SUBSCRIBED AND SWORN TO before me this 7th day of Nov., 1955

My commission expires April 24 - 1956 Notary Public.

PLUGGING  
FILED SEC 17 T 9 R 18W  
BOOK PAGE 150 LINE 20

SINCLAIR OIL & GAS COMPANY

WELL LOG

W. P. STAHL - Well #1  
 NE NE NW - 17 - 9S - 18W  
 McHale Pool  
 Rooks County - KANSAS

SPUDDED: September 25, 1948  
 CONTRACTOR: Harbar Drilling Company  
 Wichita, Kansas  
 DRILLING COMP: October 6, 1948  
 FIRST PRODUCTION: October 19, 1948  
 ELECTRIC LOG: Schlumberger 10/6/48

ELEVATION: GL 2069'  
 PAY: Arbuckle  
 TOPE 3495'  
 TOTAL DEPTH 3504'  
 8-5/8" Surf. Set 278' (A50 Sx)  
 5-1/2" O.D. Csg. Set 3496' (75 Sx)

DRILLERS LOG  
 (Corrected to GLM)

Rock & Sand	138'
Surface Clay & Shale	272'
Shale	343
Shale & Shells	418
Shale	538
Sand	593
Sand & Shale	598
Red Bed & Shells	773
Sand & Shale	1143
Red Bed & Shells	1248
Red Bed	1283
Sand	1313
Red Bed & Shale	1428
Anhydrite	1483
Red Bed	1543
Shale & Shells	1813
Salt	1853
Shale & Shells	2008
Lime & Shale	2218
Shale & Lime	2323
Lime & Shale	2407
Shale & Lime	2598
Lime & Shale	2678
Shale & Lime	2738
Lime & Shale	3168
Shale & Lime	3258
Lime	3328
Lime & Shale	<del>3578</del> 3378'
Lime	3443
Lime & Shale	3488
Lime (Top Arbuckle) 3495'	3504 (RTD)

**PLUGGING**  
 FILE SEC 17 T 9 R 18W  
 BOOK PAGE 150 LINE 20

REC'D  
 STATE CORP  
 CONSERVATION  
 Wichita, Kansas