


STATE OF KANSAS  
STATE CORPORATION COMMISSION

WELL PLUGGING RECORD

Give All Information Completely  
Make Required Affidavit  
Mail or Deliver Report to:  
Conservation Division  
State Corporation Commission  
800 Bitting Building  
Wichita, Kansas

Rooks County. Sec. 17 Twp. 9S Rge. ~~18~~ 18 (W)

Location as "NE/CNW $\frac{1}{4}$ SW $\frac{1}{4}$ " or footage from lines NW SW NE  
Lease Owner The Bay Petroleum Corporation  
Lease Name E. Hilgers Well No. 1  
Office Address P.O. Box 957, Denver, Colorado.  
Character of Well (completed as Oil, Gas or Dry Hole) Dry Hole  
Date well completed Feb. 25, 19 50  
Application for plugging filed Feb. 28, 19 50  
Application for plugging approved 19  
Plugging commenced Feb. 25 19 50  
Plugging completed Feb. 25 19 50  
Reason for abandonment of well or producing formation.

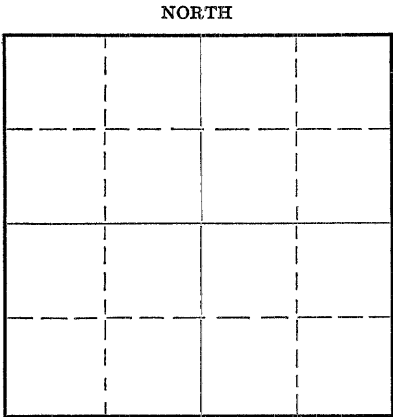

Locate well correctly on above  
Section Flat

Dry Hole  
If a producing well is abandoned, date of last production None 19  
Was permission obtained from the Conservation Division or its agents before plugging was commenced? Yes

Name of Conservation Agent who supervised plugging of this well Mr. C.D. Stough  
Producing formation Depth to top Bottom Total Depth of Well 3593 Feet  
Show depth and thickness of all water, oil and gas formations.

OIL, GAS OR WATER RECORDS

CASING RECORD

Formation	Content	From	To	Size	Put In	Pulled Out
				8 5/8"	250'	none

Describe in detail the manner in which the well was plugged, indicating where the mud fluid was placed and the method or methods used in introducing it into the hole. If cement or other plugs were used, state the character of same and depth placed, from feet to feet for each plug set.

Pumped mud from total depth to 250',  
ran 15 sacks cement,  
mud to 35',  
ran 10 sacks cement to base of cellar.

MAR 3 1950  
3-3-50

(If additional description is necessary, use BACK of this sheet)

Correspondence regarding this well should be addressed to The Bay Petroleum Corporation  
Address Box 513, Chase, Kansas


STATE OF Kansas, COUNTY OF Rice, ss.  
Glen E. Armour (employee of owner) or (owner or operator) of the above-described well,  
being first duly sworn on oath, says: That I have knowledge of the facts, statements, and matters herein contained and the log of the above-described well as filed and that the same are true and correct. So help me God.

(Signature) Glen E. Armour  
(Address)

SUBSCRIBED AND SWORN TO before me this 2nd day of March, 19 50

My commission expires May, 20, 1950  
Vincent O. Gray Notary Public.

22-7377-s 4-49-10M

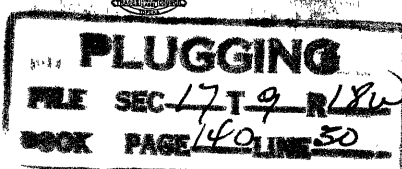

Chase

COMPANY: BAY PETROLEUM CORPORATION  
Wichita, Kansas

Rotary Drilling Commenced: 2-16-50  
Rotary Drilling Completed: 2-25-50

LOCATION: E. HILBERS #1  
NW SW NE Sec. 17-28-15W  
Rooks County, Kansas

CASING RECORD: 255' (11 jts) 8 5/8" New 22# Logwell casing set at 255'  
in a 12 1/4" hole, cemented with 125 sacks cement.  
Drilled 7 7/8" hole from 255' to 2695' T.D. No oil string run.

LOG  
(Figures indicate bottom of formation)

Cellar	5	Circulate for samples at 5430'	
Shale & Shells	1025	" " " " 5824'	
Sand	1155	" " " " 5833'	
Shale & Shells	1250	" " " " 5840'	
Shale	1455	" " " " 5848'	
Anhydrite	1480		
Shale	1570	Slope Test at 500'	- 0° off
Shale & Shells	2200	" " " " 1000'	- 0° off
Lime	2440	Slope Test & S.L.M. at 1500'	- OK
Shale & Lime	2525	" " " " 2000'	- OK
Lime & Shale	2710	" " " " 2800'	- OK
Lime	2900	Slope Test at 2900'	- 0° off
Lime & Shale	3025	Strapped Drill Pipe at 2815'	- OK
Lime	3174	S.L.M. at 3595'	- OK
Lime & Shale	3215		
Lime	3435		
Lime & Shale	3490		
Lime	3525		
Conglomerat & Lime	3595 Rotary TD		

Hole filled with heavy rotary mud from total depth 3595' to 250'. Set bridge at 250' and cemented with 15 sacks, filled hole to 210'. Filled with heavy mud to 20', set bridge at 20' and cemented with 10 sacks to bottom of cellar. Plugging completed at 5:00 P.M. 2-25-50.

Lost Circulation at 2975'  
" " " " 3451'

The undersigned, G. W. Sebitts, Secretary of PICKRELL DRILLING COMPANY, INC., hereby certifies in behalf of said corporation, that the above log is a true and correct log of the formation encountered in drilling the above well as reflected by the Daily Drilling Reports.

PICKRELL DRILLING COMPANY, INC.  
By [Signature]  
Secretary

MAR 17 1950  
STATE OF KANSAS  
COUNTY OF SEDGWICK

STATE OF KANSAS }  
COUNTY OF SEDGWICK } 38

BE IT REMEMBERED that on this 6th day of March, 1950, before me, the undersigned, a Notary Public, duly commissioned, in and for the county and state aforesaid, name G. W. Sebitts, Secretary of Pickrell Drilling Company, Inc., a corporation of the State of Kansas, personally known to me to be such officer, and to be the same person who executed as such officer the foregoing instrument of writing in behalf of said corporation, and he duly acknowledged the execution of the same for himself and for said corporation.

IN WITNESS WHEREOF, I have hereunto set my hand and official seal on this day and year last above written.

Ethel Zimmerman  
Notary Public

My commission expires January 20, 1953.

PLUGGING  
FILE SEC 17 T 9 R 18 W  
BOOK PAGE 140 LINE 30