

CARD MUST BE TYPED

State of Kansas

CARD MUST BE SIGNED

### NOTICE OF INTENTION TO DRILL

(see rules on reverse side)

Expected Spud Date..... 03- 15- 88  
month day year

API Number 15-073-23,585-00-00

OPERATOR: License #..... 5556  
Name Viva Oil Company, Inc.  
Address 101 West 10th Avenue  
City/State/Zip No. Kansas City, MO 64116  
Contact Person Vickie L. Turner  
Phone (816)421-5636

NE SE NW Sec. 22 Twp. 23 S, Rg. 10  East  
3630 West  
3140 Ft. from South Line of Section  
Ft. from East Line of Section

(Note: Locate well on Section Plat on reverse side)

CONTRACTOR: License #.....  
Name Unknown  
City/State.....

Nearest lease or unit boundary line 990 feet  
County Greenwood

Lease Name Edwards Well # 14  
Ground surface elevation est. 1300 feet MSL

Well Drilled For: Well Class: Type Equipment:  
 Oil  Storage  Infield  Mud Rotary  
 Gas  Inj  Pool Ext.  Air Rotary  
 OWWO  Expl  Wildcat  Cable

Domestic well within 330 feet:  yes  no  
Municipal well within one mile:  yes  no

Depth to bottom of fresh water 30'  
Depth to bottom of usable water 200'

If OWWO: old well info as follows:

Surface pipe by Alternate: 1  2   
Surface pipe planned to be set 200'

Operator.....  
Well Name.....  
Comp Date..... Old Total Depth.....

Conductor pipe required None  
Projected Total Depth 2330 feet

I certify that well will comply with K.S.A. 55-101, et seq., plus eventually plugging hole to KCC specifications.

Date 3-2-88 Signature of Operator or Agent Vickie L. Turner Title Asst. Secretary  
Vickie L. Turner

For KCC Use:

Conductor Pipe Required ..... feet; Minimum Surface Pipe Required ..... feet per Alt. 200  
This Authorization Expires 9-3-88 Approved By [Signature] 3-3-88


EFFECTIVE DATE: 3-8-88

Must be filed with the K.C.C. five (5) days prior to commencing well  
This card void if drilling not started within six (6) months of date received by K.C.C.

### Important procedures to follow:

1. Notify District office before setting surface casing.
2. Set surface casing by circulating cement to the top.
3. File completion forms ACO-1 with K.C.C. within 120 days of well spud date, following instructions on ACO-1, side 1, and including copies of wireline logs.
4. Notify District office 48 hours prior to old well workover or re-entry.
5. Prior to filing Intent, prepare a proposed plugging plan in case well is D & A, then obtain approval of plan when calling district office prior to setting surface pipe.
6. Submit plugging report (CP-4) to K.C.C. after plugging is completed.
7. Obtain an approved injection docket number before disposing of salt water.
8. Notify K.C.C. within 10 days when injection commences or terminates.

### A Regular Section of Land 1 Mile = 5,280 Ft.

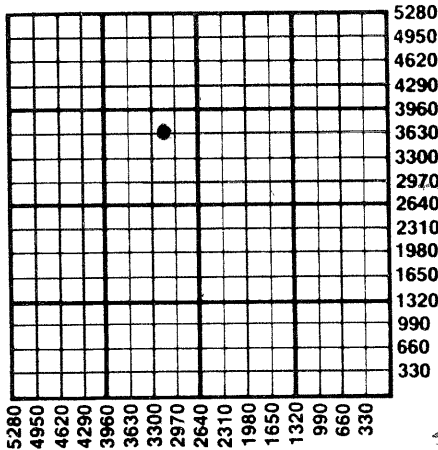

If an alternate 2 completion, cement in the production pipe from  
below any usable water to surface within 120 days of spud date.

STATE CORPORATION COMMISSION  
3/13/88  
3-13-1988  
RECEIVED  
STATE CORPORATION COMMISSION

State Corporation Commission of Kansas  
Conservation Division  
200 Colorado Derby Building  
Wichita, Kansas 67202-1212  
(316) 263-3238