

CARD MUST BE TYPED

State of Kansas

CARD MUST BE SIGNED

NOTICE OF INTENTION TO DRILL

(see rules on reverse side)

Starting Date 3-1-87
month day year

API Number 15— 073-23,550-00-00

OPERATOR: License # 5556

SW. East
SW. NE Sec. 22... Twp. 23. S, Rg. 10... West

Name Viva Oil Company, Inc.

2690 Ft. from South Line of Section

Address 101 West 10th Avenue

2540 Ft. from East Line of Section

City/State/Zip North Kansas City, MO... 64116

(Note: Locate well on Section Plat on reverse side)

Contact Person Vickie L. Turner

Phone (816) 421-5636

Nearest lease or unit boundary line 50 feet

CONTRACTOR: License #

County.. Greenwood

Name Unknown

Lease Name.. Edwards Well #.. 12

City/State

Ground surface elevation ... 1350 feet MSL

Well Drilled For: Well Class: Type Equipment:

Domestic well within 330 feet: ___yes no

___ Oil ___ SWD Infield Mud Rotary

Municipal well within one mile: ___yes no

___ Gas Inj ___ Pool Ext. ___ Air Rotary

Surface pipe by Alternate: 1 2

___ OWWO ___ Expl ___ Wildcat ___ Cable

Depth to bottom of fresh water

If OWWO: old well info as follows:

Depth to bottom of usable water . 200

Operator

Surface pipe planned to be set 200

Well Name

Projected Total Depth 2250 feet

Comp Date Old Total Depth

Formation.... Bartlesville

I certify that well will comply with K.S.A. 55-101, et seq., plus eventually plugging hole to KCC specifications.

_____ cementing will be done immediately upon setting production casing.

Signature

Date .. 2-18-87 Signature of Operator or Agent *Vickie L. Turner* Title... Asst. Secretary

For KCC Use:

Conductor Pipe Required feet; Minimum Surface Pipe Required 200 feet per Alt.


This Authorization Expires 2-23-87 Approved By 2-23-87

Must be filed with the K.C.C. five (5) days prior to commencing well
 This card void if drilling not started within six (6) months of date received by K.C.C.

Important procedures to follow:

1. Notify District office before setting surface casing.
2. Set surface casing by circulating cement to the top.
3. File completion forms ACO-1 with K.C.C. within 90 days of well completion, following instructions on ACO-1, side 1, and including copies of wireline logs.
4. Notify District office 48 hours prior to old well workover or re-entry.
5. Prior to filing Intent, prepare a proposed plugging plan in case well is D & A, then obtain approval of plan when calling district office prior to setting surface pipe.
6. Submit plugging report (CP-4) to K.C.C. after plugging is completed.
7. Obtain an approved injection docket number before disposing of salt water.
8. Notify K.C.C. within 10 days when injection commences or terminates.
9. If an alternate 2 completion, cement in the production pipe from below any usable water to surface within 120 days of spud date.

A Regular Section of Land
1 Mile = 5,280 Ft.

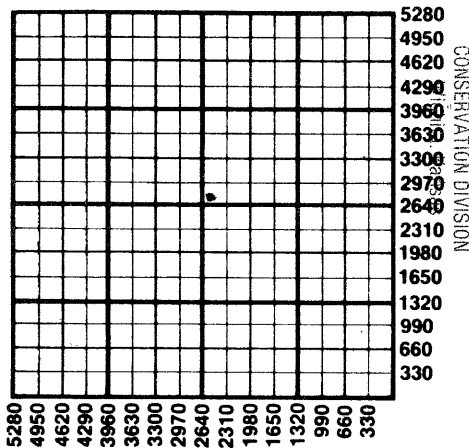

RECEIVED
 2/23/87
 FEB 23 4 01 /
 STATE CORPORATION COMMISSION
 CONSERVATION DIVISION

State Corporation Commission of Kansas
 Conservation Division
 200 Colorado Derby Building
 Wichita, Kansas 67202
 (316) 263-3238