

CARD MUST BE TYPED

State of Kansas
NOTICE OF INTENTION TO DRILL
(see rules on reverse side)

CARD MUST BE SIGNED

Starting Date: August 12, 1985
month day year

API Number 15- 073-23,466-00-06

OPERATOR: License # 5556
Name Viva Oil Company, Inc.
Address 101 West 10th Avenue
City/State/Zip North Kansas City, MO 64116
Contact Person Henry E. Ritter, Jr.
Phone (816) 421-5636

SW NE NE Sec 22 Twp 23 S, Rge 10 East
(location) West
4290 Ft North from Southeast Corner of Section
990 Ft West from Southeast Corner of Section
(Note: Locate well on Section Plat on reverse side)

CONTRACTOR: License # 6090
Name Jackman and Jackman
City/State Madison, Kansas

Nearest lease or unit boundary line 990 feet.
County Greenwood
Lease Name Edwards Well# 11

Well Drilled For: Well Class: Type Equipment:
 Oil Swd Infield Mud Rotary
 Gas Inj Pool Ext. Air Rotary
 OWWO Expl Wildcat Cable

Domestic well within 330 feet: yes no
Municipal well within one mile: yes no

If OWWO: old well info as follows:

Operator
Well Name
Comp Date Old Total Depth
Projected Total Depth 2200 feet
Projected Formation at TD Bartlesville
Expected Producing Formations Bartlesville

Depth to Bottom of fresh water 100 feet
Lowest usable water formation
Depth to Bottom of usable water 200 feet
Surface pipe by Alternate: 1 2
Surface pipe to be set 200 feet
Conductor pipe if any required
Ground surface elevation 1266 feet MSL
This Authorization Expires 2-7-86
Approved By 8-7-85

I certify that we will comply with K.S.A. 55-101, et seq., plus eventually plugging hole to K.C.C. specifications.

8-5-85

Date Signature of Operator or Agent

Henry E. Ritter, Jr.

Secretary


RCH for KONE

CONSERVATION DIVISION
Wichita, Kansas

RECEIVED
AUG 7 8 18
STATE CORPORATION COMMISSION

Must be filed with the K.C.C. five (5) days prior to commencing well
This card void if drilling not started within six (6) months of date received by K.C.C.

A Regular Section of Land
1 Mile = 5,280 Ft.

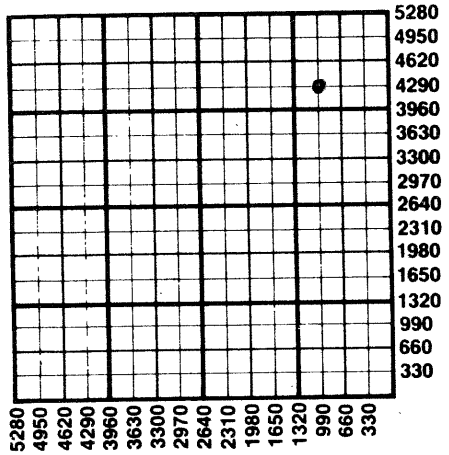

Important procedures to follow :

1. Notify District office before setting surface casing.
2. Set surface casing by circulating cement to the top.
3. File completion forms ACO-1 with K.C.C. within 90 days of well completion, following instructions on ACO-1, side 1, and including copies of wireline logs.
4. Notify District office 48 hours prior to old well workover or re-entry.
5. Prior to plugging, prepare a plugging plan, then obtain agreement from the appropriate district office for an approved plugging plan.
6. Submit plugging report (CP-4) to K.C.C. after plugging is completed.
7. Obtain an approved injection docket number before disposing of salt water.
8. Notify K.C.C. within 10 days when injection commences or terminates.
9. If an alternate 2 completion, cement in the production pipe from below any usable water to surface within 120 days of spud date.

State Corporation Commission of Kansas
Conservation Division
200 Colorado Derby Building
Wichita, Kansas 67202
(316) 263-3238