

CARD MUST BE TYPED

State of Kansas
NOTICE OF INTENTION TO DRILL
(see rules on reverse side)

CARD MUST BE SIGNED

Starting Date: 06 10 85
month day year

OPERATOR: License # 5556
Name Viva Oil Company, Inc.
Address 101 West 10th Avenue
City/State/Zip North Kansas City, MO 64116
Contact Person Henry E. Ritter, Jr.
Phone (816) 421-5636

CONTRACTOR: License # 6090
Name Jackman & Jackman
City/State Madison, Kansas

Well Drilled For:	Well Class:	Type Equipment:
<input checked="" type="checkbox"/> Oil	<input type="checkbox"/> Swd	<input checked="" type="checkbox"/> Infield
<input type="checkbox"/> Gas	<input type="checkbox"/> Inj	<input type="checkbox"/> Air Rotary
<input type="checkbox"/> OWWO	<input type="checkbox"/> Expl	<input type="checkbox"/> Cable
	<input type="checkbox"/> Wildcat	

If OWWO: old well info as follows:

Operator
Well Name
Comp Date Old Total Depth
Projected Total Depth 2150 feet
Projected Formation at TD Cherokee
Expected Producing Formations Cattleman

API Number 15- 073-23,431-00-00
75' N of C
SE. SE NW. ... Sec 22. Twp 23. S, Rge 10. East
(location) West

.3045 Ft North from Southeast Corner of Section
.2970 Ft West from Southeast Corner of Section
(Note: Locate well on Section Plat on reverse side)

Nearest lease or unit boundary line 330' feet.

County Greenwood

Lease Name Edwards Well# 10

Domestic well within 330 feet: yes no

Municipal well within one mile: yes no

Depth to Bottom of fresh water 30 feet

Lowest usable water formation

Depth to Bottom of usable water 200 feet

Surface pipe by Alternate: 1 2

Surface pipe to be set 200 feet

Conductor pipe if any required

Ground surface elevation 1255 feet MSL

This Authorization Expires 11-30-85

Approved By 5-30-85 RCH
RCH for KOKH

I certify that we will comply with K.S.A. 55-101, et seq., plus eventually plugging hole to K.C.C. specifications.


Date 5/28/85 Signature of Operator or Agent

Henry E. Ritter, Jr.

Secretary

Must be filed with the K.C.C. five (5) days prior to commencing well
This card void if drilling not started within six (6) months of date received by K.C.C.

A Regular Section of Land
1 Mile = 5,280 Ft.

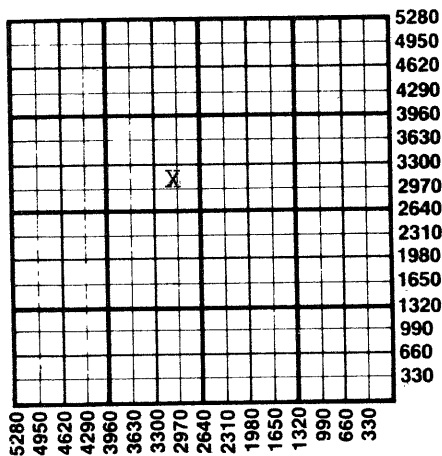

Important procedures to follow

1. Notify District office before setting surface casing.
2. Set surface casing by circulating cement to the top.
3. File completion forms ACO-1 with K.C.C. within 90 days of well completion, following instructions on ACO-1, side 1 and including copies of wireline logs.
4. Notify District office 48 hours prior to old well workover or re-entry.
5. Prior to plugging, prepare a plugging plan, then obtain agreement from the appropriate district office for an approved plugging plan.
6. Submit plugging report (CP-4) to K.C.C. after plugging is completed.
7. Obtain an approved injection docket number before disposing of salt water.
8. Notify K.C.C. within 10 days when injection commences or terminates.
9. If an alternate 2 completion, cement in the production pipe from below any usable water to surface within 120 days of spud date.

RECEIVED
STATE CORPORATION COMMISSION
5/30/85
MAY 30 1985
CONSERVATION DIVISION
Wichita, Kansas

State Corporation Commission of Kansas
Conservation Division
200 Colorado Derby Building
Wichita, Kansas 67202
(316) 263-3238