

CARD MUST BE TYPED

State of Kansas
NOTICE OF INTENTION TO DRILL
 (see rules on reverse side)

CARD MUST BE SIGNED

Starting Date: April 29 1985
 month day year

API Number 15- 207-25,248-00-00

OPERATOR: License # 5935
 Name Mark L. Haas Oil Co.
 Address 711 So. Grove
 City/State/Zip Yates Center, Ks. 66783
 Contact Person Jean Fick
 Phone 316/625-2171

SE SE NW $\frac{1}{4}$ Sec 18 Twp 26 S, Rge 15 ☒ East
 (location) ☐ West

2740 Ft North from Southeast Corner of Section
 2940 Ft West from Southeast Corner of Section
 (Note: Locate well on Section Plat on reverse side)

CONTRACTOR: License # 7721
 Name Coconut Drilling, Inc.
 City/State Yates Center, Kansas

Nearest lease or unit boundary line 2340 feet.
 County Woodson
 Lease Name O. L. Lauber Well# 7

Domestic well within 330 feet: ☐ yes ☒ no
 Municipal well within one mile: ☐ yes ☒ no

Well Drilled For:	Well Class:	Type Equipment:
☒ Oil ☐ Swd	☒ Infield	☒ Mud Rotary
☐ Gas ☐ Inj	☐ Pool Ext.	☐ Air Rotary
☐ OWWO ☐ Expl	☐ Wildcat	☐ Cable

If OWWO: old well info as follows:

Operator
 Well Name
 Comp Date Old Total Depth
 Projected Total Depth 1400 feet
 Projected Formation at TD Squirrel
 Expected Producing Formations

Depth to Bottom of fresh water 18 feet
 Lowest usable water formation
 Depth to Bottom of usable water 150 225 feet
 Surface pipe by Alternate: 1 ☐ 2 ☒
 Surface pipe to be set 40 feet
 Conductor pipe if any required feet
 Ground surface elevation feet MSL
 This Authorization Expires 10-23-85
 Approved By 4-23-85 R

I certify that we will comply with K.S.A. 55-101, et seq., plus eventually plugging hole to K.C.C. specifications.

Date 4-22-85 Signature of Operator or Agent *Mark L. Haas* Title Operator

Form C-1 4/84


WHC/MOHE 4-23-85

Must be filed with the K.C.C. five (5) days prior to commencing well
This card void if drilling not started within six (6) months of date received by K.C.C.

42385

Important procedures to follow: **RECEIVED**
STATE CORPORATION COMMISSION

A Regular Section of Land
1 Mile = 5,280 Ft.

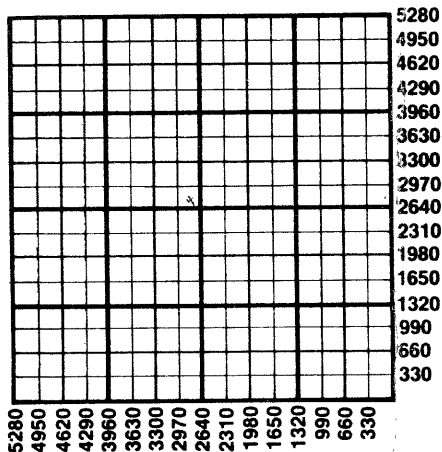

1. Notify District office before setting surface casing.
2. Set surface casing by circulating cement to the top.
3. File completion forms ACO-1 with K.C.C. within 90 days of well completion, following instructions on ACO-1, side B, and including copies of wireline logs.
4. Notify District office 48 hours prior to old well workover or re-entry.
5. Prior to plugging, prepare a plugging plan, then obtain agreement from the appropriate district office for an approved plugging plan.
6. Submit plugging report (CP-4) to K.C.C. after plugging is completed.
7. Obtain an approved injection docket number before disposing of salt water.
8. Notify K.C.C. within 10 days when injection commences or terminates.
9. If an alternate 2 completion, cement in the production pipe from below any usable water to surface within 120 days of spud date.

State Corporation Commission of Kansas
Conservation Division
200 Colorado Derby Building
Wichita, Kansas 67202
(316) 263-3238