


STATE OF KANSAS
STATE CORPORATION COMMISSION

Give All Information Completely
Make Required Affidavit
Mail or Deliver Report to:
Conservation Division
State Corporation Commission
212 No. Market
Wichita, Kansas

WELL PLUGGING RECORD

NORTH

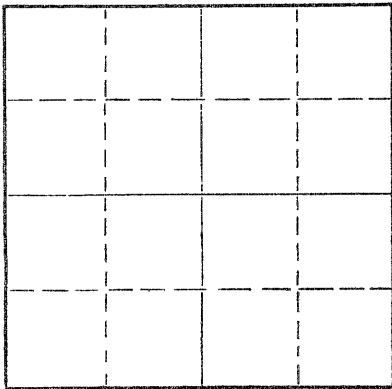

Locate well correctly on above
Section Plat

Rocks _____ County. Sec. 6 Twp. 9 S Rge. 18W (E) _____ (W) _____

Location as "NE/CNW/SW" or footage from lines _____
Clinton Oil Company

Lease Owner _____ Thompson _____ Well No. 2

Lease Name _____ Wichita, Kansas _____

Office Address _____

Character of Well (completed as Oil, Gas or Dry Hole) Oil

Date well completed January 11, 1955 19 55

Application for plugging filed November 2 19 67

Application for plugging approved November 3 19 67

Plugging commenced 12/21/67 19 _____

Plugging completed 12/30/67 19 _____

Reason for abandonment of well or producing formation depleted.

If a producing well is abandoned, date of last production April 30 19 67

Was permission obtained from the Conservation Division or its agents before plugging was commenced? yes

Name of Conservation Agent who supervised plugging of this well Massey

Producing formation _____ Depth to top _____ Bottom _____ Total Depth of Well 3490 Feet

Show depth and thickness of all water, oil and gas formations.

OIL, GAS OR WATER RECORDS

CASING RECORD

FORMATION	CONTENT	FROM	TO	SIZE	PUT IN	PULLED OUT
				8-5/8"	205'	none
				6"	3490'	1615'

Describe in detail the manner in which the well was plugged, indicating where the mud fluid was placed and the method or methods used in introducing it into the hole. If cement or other plugs were used, state the character of same and depth placed, from _____ feet to _____ feet for each plug set.

Checked bottom, pushed plug to 3200', dumped 20 gallons sand.
Dumped 5 sacks of cement. Shot pipe at 2430', 2127', 1968', 1878',
1785', 1694', 1907', worked pipe loose and pulled 54 pints.
Had Globe pump 35 sacks gel, 4 sacks hulls. Pumped 150 sacks of
cement. Tallied pipe.

PLUGGING COMPLETE.

RECEIVED
STATE CORPORATION COMMISSION
JAN 10 1968
CONSERVATION DIVISION
Wichita, Kansas

(If additional description is necessary, use BACK of this sheet)
Name of Plugging Contractor KNIGHT CASING PULLING COMPANY, INC.
Address CHASE, KANSAS

STATE OF KANSAS COUNTY OF Rice, ss.
Noel J. Knight

(employee of owner) or (owner or operator) of the above-described well, being first duly sworn on oath, says: That I have knowledge of the facts, statements, and matters herein contained and the log of the above-described well as filed and that the same are true and correct. So help me God.

(Signature) Noel J. Knight
Chase, Kansas

(Address)

SUBSCRIBED AND SWORN to before me this 31st day of December, 19 67

My commission expires February 15, 1971

Margaret Melcher
Notary Public.

15-163-01529-00-00 ^{480.}

WELL LOG
CONTINENTAL OIL COMPANY
E. A. Thompson #2

RECEIVED
STATE CORPORATION COMMISSION
11/3/67
NOV 3 1967

CONSERVATION DIVISION
Wichita, Kansas

Described as your E. A. Thompson well No.2
located in Section 6, Township 9 South,
Range 18 West, Rooks County, Kansas.

<u>FORMATION</u>	<u>FROM</u>	<u>TO</u>
Rock & Sand	0	130
Shale	130	220
Shale	220	310
Shale & Shells	310	920
Shale & Shells	920	940
Sand	940	1170
Shale & Shells	1170	1437
Lime	1437	1485
Shale & Shells	1485	2022
Lime	2022	2027
Lime broken	2027	2296
Lime	2296	2370
Broken lime	2370	3038
Lime	3038	3485
Total depth	3485'	

*(Reopened to 3490' with standard tools)
Copy to Geol. Dept 3-24-48*



3-24-48