

CARD MUST BE SIGNED

API Number 15- 207- 24, 964- 00 00

SE .. SW Sec 25 .. Twp 26 .. S, Rge 16. ☒ East
(location) ☐ West

...733..... Ft North from Southeast Corner of Section
 ...280.5..... Ft West from Southeast Corner of Section
 (Note: Locate well on Section Plat on reverse side)

Nearest lease or unit boundary line .16.5..... feet.
County ... Woodson.....
Lease Name ..Lorance..... Well# ..2-84..
Domestic well within 330 feet : ☐ yes ☒ no
Municipal well within one mile : ☐ yes ☒ no

Operator

Well Name

Comp Date **Old Total Depth**

Projected Total Depth 9.50..... feet

Projected Formation at TD.....Squirrel.....

Expected Producing Formations

Depth to Bottom of fresh water 40..... feet
Lowest usable water formation
Depth to Bottom of usable water 250..... feet
Surface pipe by Alternate: 1 ☐ 2 ☒
Surface pipe to be set ..40..... feet
Conductor pipe if any required feet
Ground surface elevation ...98.25..... feet MSL
This Authorization Expires 1/23/85
Approved By 7/23/84

I certify that we will comply with K.S.A. 55-101, et seq., plus eventually plugging hole to K.C.C. specifications.


Date 7-23-84 Signature of Operator or Agent Muenda Moorhead Title As Agent

Form C-1 4/84

мис/коне 7-23-84

Must be filed with the K.C.C. five (5) days prior to commencing well
This card void if drilling not started within six (6) months of date received by K.C.C.

RECEIVED
STATE CORPORATION COMMISSION
MAY 23 1984
CONSERVATION DIVISION
Wichita, Kansas
A Regular Section of Land
1 Mile - 5,280 Ft.

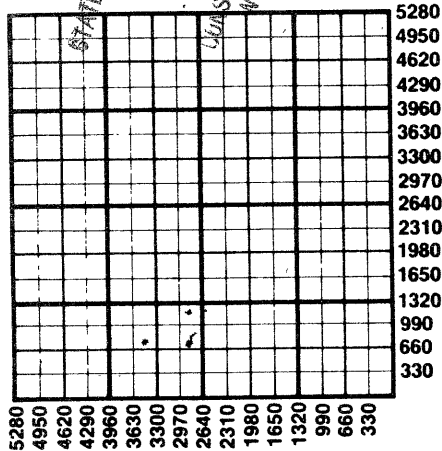

Important procedures to follow :

1. Notify District office before setting surface casing.
2. Set surface casing by circulating cement to the top.
3. File completion forms ACO-1 with K.C.C. within 90 days of well completion, following instructions on ACO-1, side 1, and including copies of wireline logs.
4. Notify District office 48 hours prior to old well workover or re-entry.
5. Prior to plugging, prepare a plugging plan, then obtain agreement from the appropriate district office for an approved plugging plan.
6. Submit plugging report (CP-4) to K.C.C. after plugging is completed.
7. Obtain an approved injection docket number before disposing of salt water.
8. Notify K.C.C. within 10 days when injection commences or terminates.
9. If an alternate 2 completion, cement in the production pipe from below any usable water to surface within 120 days of spud date.

**State Corporation Commission of Kansas
Conservation Division
200 Colorado Derby Building
Wichita, Kansas 67202
(316) 263-3238**