

CARD MUST BE TYPED

State of Kansas
NOTICE OF INTENTION TO DRILL
(see rules on reverse side)

CARD MUST BE SIGNED

Starting Date: April 30 1985
month day year

API Number 15- 207-25,249-00-00

OPERATOR: License # 6859
Name ~~Al-Kan Drilling Co~~ Al-Kan Drilling Co

~~SE NW 30~~ Sec 25. Twp 26. S, Rge 16.. East
(location) West

Address Rt. 1

1520 Ft North from Southeast Corner of Section

City/State/Zip Altoona, Ks. 66710

5080 Ft West from Southeast Corner of Section

Contact Person same

(Note: Locate well on Section Plat on reverse side)

Phone 568-6058 (316)

Nearest lease or unit boundary line 200 feet.

CONTRACTOR: License # 6859

County Woodson

Name Ca. Tools Al-Kan Drilling Co.

Lease Name Lorraine Well # B. 2

City/State

Domestic well within 330 feet : yes no

Municipal well within one mile : yes no

Well Drilled For: Well Class: Type Equipment:

- | | | | |
|---|-------------------------------|---|--|
| <input checked="" type="checkbox"/> Oil | <input type="checkbox"/> Swd | <input type="checkbox"/> Infield | <input checked="" type="checkbox"/> Mud Rotary |
| <input checked="" type="checkbox"/> Gas | <input type="checkbox"/> Inj | <input checked="" type="checkbox"/> Pool Ext. | <input type="checkbox"/> Air Rotary |
| <input type="checkbox"/> OWWO | <input type="checkbox"/> Expl | <input type="checkbox"/> Wildcat | <input type="checkbox"/> Cable |

If OWWO: old well info as follows:

Operator

Well Name

Comp Date Old Total Depth

Projected Total Depth 950 feet

Projected Formation at TD Bartlesville sand

Expected Producing Formations lower squirrel

Depth to Bottom of fresh water 20 feet

Lowest usable water formation 20

Depth to Bottom of usable water 250 feet

Surface pipe by Alternate : 1 2

Surface pipe to be set 40 feet

Conductor pipe if any required none feet

Ground surface elevation feet MSL

This Authorization Expires 10-24-85

Approved By 4-24-85 *fc*

I certify that we will comply with K.S.A. 55-101, et seq., plus eventually plugging hole to K.C.C. specifications.


Date April 22 Signature of Operator or Agent Allen L. Nunnemeyer Title Owner

WHC/NOHE 4-24-85

**Must be filed with the K.C.C. five (5) days prior to commencing well
This card void if drilling not started within six (6) months of date received by K.C.C.**

Important procedures to follow :

**A Regular Section of Land
1 Mile = 5,280 Ft.**

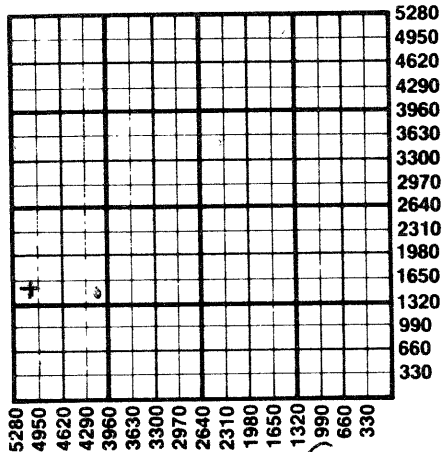

1. Notify District office before setting surface casing.
2. Set surface casing by circulating cement to the top.
3. File completion forms ACO-1 with K.C.C. within 90 days of well completion, following instructions on ACO-1, side 1, and including copies of wireline logs.
4. Notify District office 48 hours prior to old well workover or re-entry.
5. Prior to plugging, prepare a plugging plan, then obtain agreement from the appropriate district office for an approved plugging plan.
6. Submit plugging report (CP-4) to K.C.C. after plugging is completed.
7. Obtain an approved injection docket number before disposing of salt water.
8. Notify K.C.C. within 10 days when injection commences or terminates.
9. If an alternate 2 completion, cement in the production pipe from below any usable water to surface within 120 days of spud date.

RECEIVED
STATE CORPORATION COMMISSION

4-24-85
APR 24 1985

CONSERVATION DIVISION

State Corporation Commission of Kansas
Conservation Division
200 Colorado Derby Building
Wichita, Kansas 67202
(316) 263-3238