

CARD MUST BE TYPED

State of Kansas NOTICE OF INTENTION TO DRILL

(see rules on reverse side)

CARD MUST BE SIGNED

Starting Date: May 18, 1985
month day year

API Number 15- 207-25,273-0000

OPERATOR: License # 5983

NW SE SE Sec 25 Twp 26 S, Rge 16 East
(location) West

Name Victor J. Leis, ~~Leis Co.~~

Address POB. 223

City/State/Zip Yates Center, KS 66783

Contact Person Victor J. Leis

Phone 316-625-2106

825 Ft North from Southeast Corner of Section

965 Ft West from Southeast Corner of Section

(Note: Locate well on Section Plat on reverse side)

CONTRACTOR: License # 5367

Nearest lease or unit boundary line 495 feet.

County Woodson

Name Double L. Drlg. Co.

Lease Name Diver Well# 9

City/State Yates Center, KS 66783

Domestic well within 330 feet: yes no

Municipal well within one mile: yes no

Well Drilled For: Well Class: Type Equipment:

Oil Swd

Infield

Mud Rotary

Gas Inj

Pool Ext.

Air Rotary

OWWO Expl

Wildcat

Cable

Depth to Bottom of fresh water 15 feet

Lowest usable water formation N/A

Depth to Bottom of usable water 150-250 feet

Surface pipe by Alternate: 1 2

Surface pipe to be set 40 feet

Conductor pipe if any required none feet

Ground surface elevation N/A feet MSL

This Authorization Expires 11-13-85

Approved By 5-13-85 *[Signature]*

If OWWO: old well info as follows:

Operator

Well Name

Comp Date Old Total Depth

Projected Total Depth 1000 feet

Projected Formation at TD

Expected Producing Formations

I certify that we will comply with K.S.A. 55-101, et seq., plus eventually plugging hole to K.C.C. specifications.

Date May 10, 85 Signature of Operator or Agent

Victor J. Leis


Title Owner

MHC/WHITE 5-13-85

Must be filed with the K.C.C. five (5) days prior to commencing well
 This card void if drilling not started within six (6) months of date received by K.C.C.

Important procedures to follow :

A Regular Section of Land
1 Mile = 5,280 Ft.

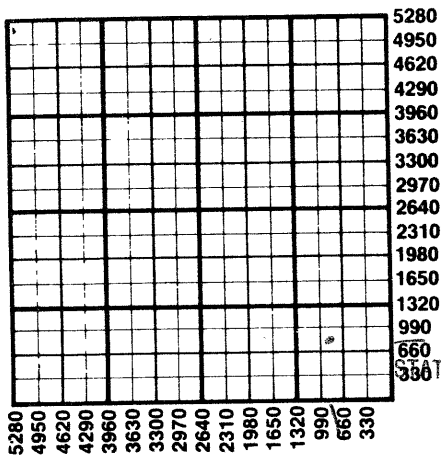

1. Notify District office before setting surface casing.
2. Set surface casing by circulating cement to the top.
3. File completion forms ACO-1 with K.C.C. within 90 days of well completion, following instructions on ACO-1, side 1, and including copies of wireline logs.
4. Notify District office 48 hours prior to old well workover or re-entry.
5. Prior to plugging, prepare a plugging plan, then obtain agreement from the appropriate district office for an approved plugging plan.
6. Submit plugging report (CP-4) to K.C.C. after plugging is completed.
7. Obtain an approved injection docket number before disposing of salt water.
8. Notify K.C.C. within 10 days when injection commences or terminates.
9. If an alternate 2 completion, cement in the production pipe from below any usable water to surface within 120 days of spud date.

RECEIVED
 STATE CORPORATION COMMISSION

MAY 15 1985

CONSERVATION DIVISION
 Wichita, Kansas
 S-13-85

State Corporation Commission of Kansas
 Conservation Division
 200 Colorado Derby Building
 Wichita, Kansas 67202
 (316) 263-3238