

CARD MUST BE TYPED

State of Kansas
NOTICE OF INTENTION TO DRILL
 (see rules on reverse side)

CARD MUST BE SIGNED

Starting Date: May 22, 1985
 month day year

OPERATOR: License # 5983
 Name Victor J. Leis ~~Drill Co.~~
 Address POB 223
 City/State/Zip Yates Center, KS 66783
 Contact Person Victor J. Leis
 Phone 316-625-2106

CONTRACTOR: License # 5367
 Name Double L Drilg Co.
 City/State Yates Center, KS

Well Drilled For:		Well Class:	Type Equipment:
<input checked="" type="checkbox"/> Oil	<input type="checkbox"/> Swd	<input checked="" type="checkbox"/> Infill	<input checked="" type="checkbox"/> Mud Rotary
<input type="checkbox"/> Gas	<input type="checkbox"/> Inj	<input type="checkbox"/> Pool Ext.	<input type="checkbox"/> Air Rotary
<input type="checkbox"/> OWWO	<input type="checkbox"/> Expl	<input type="checkbox"/> Wildcat	<input type="checkbox"/> Cable

If OWWO: old well info as follows:

Operator
 Well Name
 Comp Date Old Total Depth
 Projected Total Depth 1000 feet
 Projected Formation at TD
 Expected Producing Formations

I certify that we will comply with K.S.A. 55-101, et seq., plus eventually plugging hole to K.C.C. specifications.

Date May 10, 85
 Signature of Operator or Agent

API Number 15-107-25,275-00-00

NE SW SE Sec 25 Twp 26 S, Rge 16
 (location) ☒ East ☐ West

825 Ft North from Southeast Corner of Section
 1365 Ft West from Southeast Corner of Section
 (Note: Locate well on Section Plat on reverse side)

Nearest lease or unit boundary line 165 feet.
 County Woodson

Lease Name Diver Well# 11

Domestic well within 330 feet: ☐ yes ☒ noMunicipal well within one mile: ☐ yes ☒ no

Depth to Bottom of fresh water 15 feet

Lowest usable water formation N/A

Depth to Bottom of usable water 150.250 feet

Surface pipe by Alternate: 1 ☐ 2 ☒

Surface pipe to be set 40 feet

Conductor pipe if any required none feet

Ground surface elevation N/A feet MSL

This Authorization Expires 11-13-85

Approved By 5-13-85 *PC*

Owner


Form C-1 4/84

W H C MOHE 5-13-85

**Must be filed with the K.C.C. five (5) days prior to commencing well
This card void if drilling not started within six (6) months of date received by K.C.C.**

Important procedures to follow :

**A Regular Section of Land
1 Mile = 5,280 Ft.**

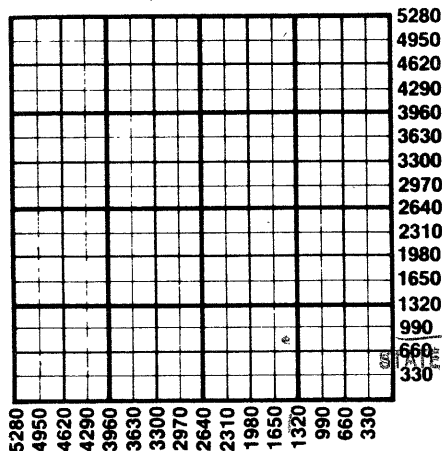

1. Notify District office before setting surface casing.
2. Set surface casing by circulating cement to the top.
3. File completion forms ACO-1 with K.C.C. within 90 days of well completion, following instructions on ACO-1, side 1, and including copies of wireline logs.
4. Notify District office 48 hours prior to old well workover or re-entry.
5. Prior to plugging, prepare a plugging plan, then obtain agreement from the appropriate district office for an approved plugging plan.
6. Submit plugging report (CP-4) to K.C.C. after plugging is completed.
7. Obtain an approved injection docket number before disposing of salt water.
8. Notify K.C.C. within 10 days when injection commences or terminates.
9. After well has 2 completion, cement in the production pipe from below any usable water to surface within 120 days of spud date.

RECEIVED

STATE CORPORATION COMMISSION

MAY 13 1985

**CONSERVATION DIVISION
Wichita, Kansas**

8-13-85

**State Corporation Commission of Kansas
Conservation Division
200 Colorado Derby Building
Wichita, Kansas 67202
(316) 263-3238**