

CARD MUST BE TYPED

State of Kansas
NOTICE OF INTENTION TO DRILL
(see rules on reverse side)

CARD MUST BE SIGNED

Starting Date: August 12 1985
month day year

API Number 15- 207-25,359-0000

OPERATOR: License # KCC 4517

NE/4, SE/4, SW/4 Sec .25. Twp 26. S, Rge .16. East West
(location)

Name B & J Developers, Inc.

Address P. O. Box 3403

City/State/Zip Bartlesville, OK 74006

Contact Person Larry D. Thrash

Phone 918-335-0850

1145 Ft North from Southeast Corner of Section

2820 Ft West from Southeast Corner of Section

(Note: Locate well on Section Plat on reverse side)

CONTRACTOR: License #

Nearest lease or unit boundary line 180 feet.

Name

County Woods on

City/State

Lease Name Lorance Well# .5

Well Drilled For: Well Class: Type Equipment:

Domestic well within 330 feet: yes no

Municipal well within one mile: yes no

- Oil Swd Infield Mud Rotary
- Gas Inj Pool Ext. Air Rotary
- OWWO Expl Wildcat Cable

Depth to Bottom of fresh water Unknown - 240 feet

Lowest usable water formation

Depth to Bottom of usable water 250 feet

Surface pipe by Alternate: 1 2

Surface pipe to be set 40 feet

Conductor pipe if any required

Ground surface elevation Unk feet MSL

This Authorization Expires 2-2-86

Approved By 8-2-85

If OWWO: old well info as follows:

Operator

Well Name

Comp Date Old Total Depth

Projected Total Depth 950 feet

Projected Formation at TD Unk

Expected Producing Formations Squirrel

I certify that we will comply with K.S.A. 55-101, et seq., plus eventually plugging hole to K.C.C. specifications.

RCA for KONE


Date 7-30-85 Signature of Operator or Agent

Title Vice President

Must be filed with the K.C.C. five (5) days prior to commencing well
This card void if drilling not started within six (6) months of date received by K.C.C.

Important procedures to follow :

**A Regular Section of Land
1 Mile = 5,280 Ft.**

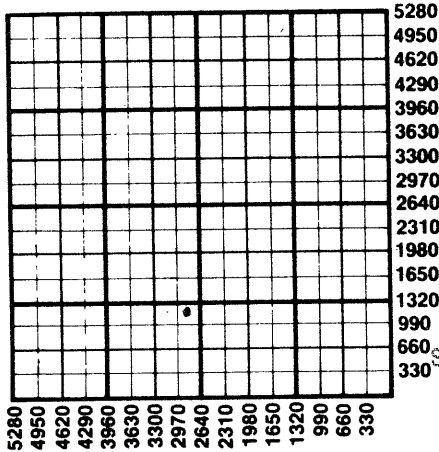

1. Notify District office before setting surface casing.
2. Set surface casing by circulating cement to the top.
3. File completion forms ACO-1 with K.C.C. within 90 days of well completion, following instructions on ACO-1, side 1, and including copies of wireline logs.
4. Notify District office 48 hours prior to old well workover or re-entry.
5. Prior to plugging, prepare a plugging plan, then obtain agreement from the appropriate district office for an approved plugging plan.
6. Submit plugging report (CP-4) to K.C.C. after plugging is completed.
7. Obtain an approved injection docket number before disposing of salt water.
8. Notify K.C.C. within 10 days when injection commences or terminates.
9. If an alternate completion, cement in the production pipe from below any usable water to surface within 120 days of spud date.

RECEIVED
STATE CORPORATION COMMISSION

AUG 2 1985

State Corporation Commission of Kansas
Conservation Division
200 Colorado Derby Building
Wichita, Kansas 67202
(316) 263-3238

CONSERVATION DIVISION
Wichita, Kansas
82-85-