

CARD MUST BE TYPED

State of Kansas

CARD MUST BE SIGNED

NOTICE OF INTENTION TO DRILL

(see rules on reverse side)

Starting Date Sept. 7 1985
month day year

API Number 15- 207-25388-00-00

OPERATOR: License # 6859
Name Al-Kan Drilling Company
Address Route 1
City/State/Zip Altoona, KS 66710
Contact Person Al-Kan Drilling Co. (Chris)
Phone 316 568 6058App. NE SW SW. Sec. 25 Twp. 26 S, Rg. 16 West
..... 1240 Ft. from South Line of Section
..... 4460 Ft. from East Line of Section

(Note: Locate well on Section Plat on reverse side)

CONTRACTOR: License # 5687
Name Sun Drilling Co. Inc.
City/State Box 54, Piqua, KS 66761Nearest lease or unit boundary line 200 feet
County Woodson

Lease Name Lorange Well # B4

Ground surface elevation feet MSL

Domestic well within 330 feet: yes ☒ noMunicipal well within one mile: yes ☒ noSurface pipe by Alternate: 1 ☒ 2 ☒

Depth to bottom of fresh water 70 feet

Depth to bottom of usable water 250 feet

Surface pipe planned to be set 40 feet

Projected Total Depth 950 feet

Formation Bartlesville

Well Drilled For: Well Class: Type Equipment:
☒ Oil ☐ SWD ☒ Infield ☒ Mud Rotary
☐ Gas ☐ Inj ☐ Pool Ext. ☐ Air Rotary
☐ OWWO ☐ Expl ☐ Wildcat ☐ Cable

If OWWO: old well info as follows:

Operator
Well Name
Comp Date Old Total Depth

I certify that well will comply with K.S.A. 55-101, et seq., plus eventually plugging hole to KCC specifications.

cementing will be done immediately upon setting production casing.

Date 9/6/85 Signature of Operator or Agent *Elaine Barlow* Title as agent

For KCC Use:

Conductor Pipe Required feet; Minimum Surface Pipe Required feet per Alt. 1 2

This Authorization Expires 3-6-86 Approved By 9-6-85 *E*

Must be filed with the K.C.C. five (5) days prior to commencing well
This card void if drilling not started within six (6) months of date received by K.C.C.


RECEIVED
STATE CORPORATION COMMISSION

SEP 6 1985

A Regular Section of Land

1 Mile = 5,280 Ft

CONSERVATION DIVISION
Wichita, Kansas

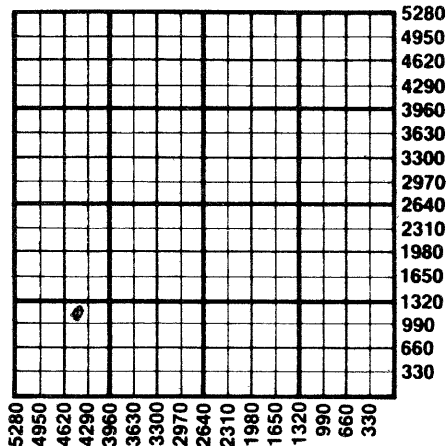

Important procedures to follow:

1. Notify District office before setting surface casing.
2. Set surface casing by circulating cement to the top.
3. File completion forms ACO-1 with K.C.C. within 90 days of well completion, following instructions on ACO-1, side 1, and including copies of wireline logs.
4. Notify District office 48 hours prior to old well workover or re-entry.
5. Prior to filing Intent, prepare a proposed plugging plan in case well is D & A, then obtain approval of plan when calling district office prior to setting surface pipe.
6. Submit plugging report (CP-4) to K.C.C. after plugging is completed.
7. Obtain an approved injection docket number before disposing of salt water.
8. Notify K.C.C. within 10 days when injection commences or terminates.
9. If an alternate 2 completion, cement in the production pipe from below any usable water to surface within 120 days of spud date.

State Corporation Commission of Kansas
Conservation Division
200 Colorado Derby Building
Wichita, Kansas 67202
(316) 263-3238