

CARD MUST BE TYPED

State of Kansas NOTICE OF INTENTION TO DRILL

(see rules on reverse side)

CARD MUST BE SIGNED

Starting Date: December 26 1984
month day year

API Number 15- 207-25,187-00-00

OPERATOR: License # 5983

NE East
SE West
NE $\frac{1}{4}$ SE $\frac{1}{4}$ SE $\frac{1}{4}$ Sec 24 Twp 26 S, Rge 16 West
(location)

Name Victor J. Leis

Address Box 223

City/State/Zip Yates Center, KS 66783

Contact Person Victor J. Leis

Phone 316-625-2106

1100 Ft North from Southeast Corner of Section

230 Ft West from Southeast Corner of Section

(Note: Locate well on Section Plat on reverse side)

CONTRACTOR: License # 5367

Name Double L Drilling

City/State Yates Center, KS 66783

Nearest lease or unit boundary line 220 feet.

County Woodson

Lease Name Elmer Diver Well# 1

Domestic well within 330 feet: yes no

Municipal well within one mile: yes no

Well Drilled For: Well Class: Type Equipment:

- Oil Swd Infield Mud Rotary
- Gas Inj Pool Ext. Air Rotary
- OWWO Expl Wildcat Cable

Depth to Bottom of fresh water 15 feet

Lowest usable water formation unknown

Depth to Bottom of usable water 150-250 feet

Surface pipe by Alternate: 1 2

Surface pipe to be set 20-40 mHC feet

Conductor pipe if any required none feet

Ground surface elevation N/A feet MSL

This Authorization Expires 12-26-89 6-26-85

Approved By Perth/KCC 12-26-84

If OWWO: old well info as follows:

Operator

Well Name

Comp Date Old Total Depth

Projected Total Depth 1100 feet

Projected Formation at TD Dartv.

Expected Producing Formations

I certify that we will comply with K.S.A. 55-101, et seq., plus eventually plugging hole to K.C.C. specifications.

Date 12-24-84 Signature of Operator or Agent

Victor J. Leis Title Owner-Operator
mHC/KOHE 12/26/84


RECEIVED
STATE CORPORATION COMMISSION

Must be filed with the K.C.C. five (5) days prior to commencing well
This card void if drilling not started within six (6) months of date received by K.C.C.

DEC 26 1984

CONSERVATION DIVISION
Wichita, Kansas
A Regular Section of Land
1 Mile = 5,280 Ft.

12-26-84

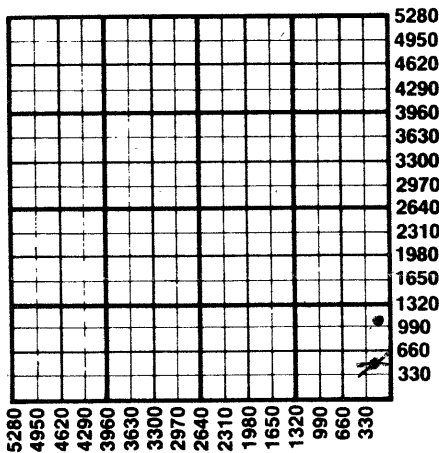

Important procedures to follow :

1. Notify District office before setting surface casing.
2. Set surface casing by circulating cement to the top.
3. File completion forms ACO-1 with K.C.C. within 90 days of well completion, following instructions on ACO-1, side 1, and including copies of wireline logs.
4. Notify District office 48 hours prior to old well workover or re-entry.
5. Prior to plugging, prepare a plugging plan, then obtain agreement from the appropriate district office for an approved plugging plan.
6. Submit plugging report (CP-4) to K.C.C. after plugging is completed.
7. Obtain an approved injection docket number before disposing of salt water.
8. Notify K.C.C. within 10 days when injection commences or terminates.
9. If an alternate 2 completion, cement in the production pipe from below any usable water to surface within 120 days of spud date.

State Corporation Commission of Kansas
Conservation Division
200 Colorado Derby Building
Wichita, Kansas 67202
(316) 263-3238