

CARD MUST BE TYPED

State of Kansas  
**NOTICE OF INTENTION TO DRILL**  
(see rules on reverse side)

CARD MUST BE SIGNED

Starting Date: July 3, 1984  
month day year

API Number 15- 207-24,925-0000

OPERATOR: License # 8782  
Name Jack Kress  
Address 910 N. Grove  
City/State/Zip Yates Center, KS 66783  
Contact Person Dennis Kress  
Phone (316) 625-3465

NW 1/4 SE Sec 24 Twp 26 S, Rge 16  East  West  
(location)

2310 Ft North from Southeast Corner of Section  
2310 Ft West from Southeast Corner of Section  
(Note: Locate well on Section Plat on reverse side)

CONTRACTOR: License # 7721  
Name Coconut Drilling, Inc.  
City/State Yates Center, KS

Nearest lease or unit boundary line 330 feet.  
County Woodson  
Lease Name Kress Well # 15

Well Drilled For: Well Class: Type Equipment:  
 Oil  Swd  Infield  Mud Rotary  
 Gas  Inj  Pool-Ext.  Air Rotary  
 OWWO  Expl  Wildcat  Cable

Domestic well within 330 feet:  yes  no  
Municipal well within one mile:  yes  no

If OWWO: old well info as follows:  
Operator .....  
Well Name .....  
Comp Date 860 Old Total Depth .....  
Projected Total Depth ..... feet  
Projected Formation at TD Squirrel  
Expected Producing Formations Squirrel

Depth to Bottom of fresh water None feet  
Lowest usable water formation None  
Depth to Bottom of usable water 150 250 feet  
Surface pipe by Alternate: 1  2   
Surface pipe to be set 40 feet  
Conductor pipe if any required None feet  
Ground surface elevation None feet MSL  
This Authorization Expires 12-28-84  
Approved By 6-28-84 hc

I certify that we will comply with K.S.A. 55-101, et seq., plus eventually plugging hole to K.C.C. specifications.


Date 6-27-84 Signature of Operator or Agent Jack Kress

Title operator  
MHC/KONE 6-28-84  
Form C-1 4/84

Must be filed with the K.C.C. five (5) days prior to commencing well  
This card void if drilling not started within six (6) months of date received by K.C.C.

**Important procedures to follow :**

**A Regular Section of Land  
1 Mile = 5,280 Ft.**

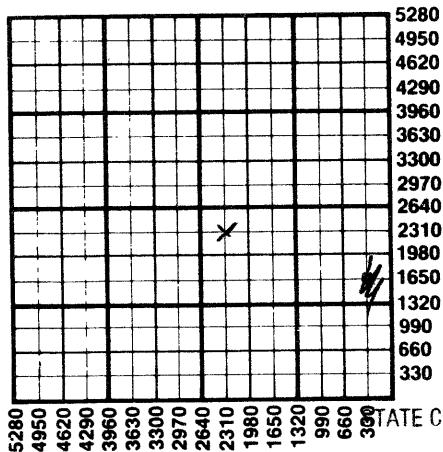

1. Notify District office before setting surface casing.
2. Set surface casing by circulating cement to the top.
3. File completion forms ACO-1 with K.C.C. within 90 days of well completion, following instructions on ACO-1, side 1, and including copies of wireline logs.
4. Notify District office 48 hours prior to old well workover or re-entry.
5. Prior to plugging, prepare a plugging plan, then obtain agreement from the appropriate district office for an approved plugging plan.
6. Submit plugging report (CP-4) to K.C.C. after plugging is completed.
7. Obtain an approved injection docket number before disposing of salt water.
8. Notify K.C.C. within 10 days when injection commences or terminates.
9. If an alternate 2 completion, cement in the production pipe from below any usable water to surface within 120 days of spud date.

RECEIVED

STATE CORPORATION COMMISSION

State Corporation Commission of Kansas  
Conservation Division  
200 Colorado Derby Building  
Wichita, Kansas 67202  
(316) 263-3238

JUN 28 1984

CONSERVATION DIVISION  
Wichita, Kansas

6-28-84