

CARD MUST BE TYPED

State of Kansas
NOTICE OF INTENTION TO DRILL

CARD MUST BE SIGNED

Starting Date: 7/27 85
month day year

API Number 15- 207-25,348-0000

OPERATOR: License # 4401
Name William W. Clarke
Address R. R. 2 Box 235
City/State/Zip Chanute Kans. 66720
Contact Person Glenn Clarke
Phone 316-537-6530

East
Woodson Co. Sec 24. Twp 26 S, Rge 16. West
(location)

2970..... Ft North from Southeast Corner of Section
2970..... Ft West from Southeast Corner of Section
(Note: Locate well on Section Plat on reverse side)

CONTRACTOR: License # 6464
Name 5 Aces Drilling Co.
City/State Yates Center, Kansas

Nearest lease or unit boundary line 165 feet.
County Woodson
Lease Name Clark Well# 2

Domestic well within 330 feet : yes no
Municipal well within one mile : yes no

Well Drilled For: Well Class: Type Equipment:
 Oil Swd Infield Mud Rotary
 Gas Inj Pool Ext. Air Rotary
 OWWO Expl Wildcat Cable

Depth to Bottom of fresh water 20 feet
Lowest usable water formation unknown
Depth to Bottom of usable water unknown 250 feet

If OWWO: old well info as follows:

Operator
Well Name Clark #2
Comp Date Old Total Depth
Projected Total Depth 1000' feet
Projected Formation at TD 1000' Cattleman
Expected Producing Formations Squirell, cattleman, wayside

Surface pipe by Alternate : 1 2
Surface pipe to be set 30 40 min feet
Conductor pipe if any required unknown feet
Ground surface elevation feet MSL
This Authorization Expires 1-23-86
Approved By R.H. 7-23-85


I certify that we will comply with K.S.A. 55-101, et seq., plus eventually plugging hole to K.C.C. specifications.

Date 7/18/85 Signature of Operator or Agent William W. Clarke Title operator

**Must be filed with the K.C.C. five (5) days prior to commencing well
This card void if drilling not started within six (6) months of date received by K.C.C.**

Important procedures to follow :

**A Regular Section of Land
1 Mile = 5,280 Ft.**

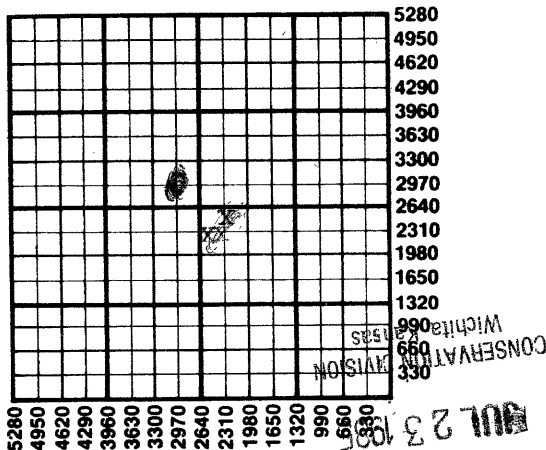

1. Notify District office before setting surface casing.
2. Set surface casing by circulating cement to the top.
3. File completion forms ACO-1 with K.C.C. within 90 days of well completion, following instructions on ACO-1, side 1, and including copies of wireline logs.
4. Notify District office 48 hours prior to old well workover or re-entry.
5. Prior to plugging, prepare a plugging plan, then obtain agreement from the appropriate district office for an approved plugging plan.
6. Submit plugging report (CP-4) to K.C.C. after plugging is completed.
7. Obtain an approved injection docket number before disposing of salt water.
8. Notify K.C.C. within 10 days when injection commences or terminates.
9. If an alternate 2 completion, cement in the production pipe from below any usable water to surface within 120 days of spud date.

RECEIVED
STATE CORPORATION COMMISSION
AUG 23 1985

State Corporation Commission of Kansas
Conservation Division
200 Colorado Derby Building
Wichita, Kansas 67202
(316)263-3238

58-22-1