

CARD MUST BE TYPED

State of Kansas

CARD MUST BE SIGNED

NOTICE OF INTENTION TO DRILL

(see rules on reverse side)

Expected Spud Date..... 11/30/88
month day year
9091

API Number 15- 207-25,580-0000 XX

OPERATOR: License #
Name RUBOIL, INC.
Address 108 N. HIGHLAND
City/State/Zip CHANUTE 66720
Contact Person JOHN C RUBOW
Phone (316) 431-7307
5661

App- SW SE SE 04 26 17 - East
450 Sec Twp..... S, Rg..... West
1000 Ft. from South Line of Section
Ft. from East Line of Section

(Note: Locate well on Section Plat on reverse side)

CONTRACTOR: License #
Name KELLY DOWN DRILLING CO.
City/State NEOSHO FALLS 66758

Nearest lease or unit boundary line 450 feet
County WOODSON
Lease Name NOLD Well # 1

Well Drilled For: Well Class: Type Equipment:
XX Oil Storage XX Infield Mud Rotary
Gas Inj Pool Ext. Air Rotary
OWWO Expl Wildcat Cable

Ground surface elevation feet MSL
Domestic well within 330 feet: -yes XX no
Municipal well within one mile: -yes -no

If OWWO: old well info as follows:
Operator
Well Name
Comp Date Old Total Depth.....

Depth to bottom of fresh water
Depth to bottom of usable water 200
Surface pipe by Alternate: 20' - 2'
Surface pipe planned to be set
Conductor pipe required
Projected Total Depth 1100 feet
Formation SQUIRREL

I certify that well will comply with K.S.A. 55-101, et seq., plus eventually plugging hole to KCC specifications.
Date Signature of Operator or Agent Title AS AGENT

For KCC Use:
Conductor Pipe Required feet; Minimum Surface Pipe Required 20' feet per Alt.
This Authorization Expires 5-29-89 Approved By LKM 11-29-88

EFFECTIVE DATE: 12-4-88


Must be filed with the K.C.C. five (5) days prior to commencing well
This card void if drilling not started within six (6) months of date received by K.C.C.

Important procedures to follow:

1. Notify District office before setting surface casing.
2. Set surface casing by circulating cement to the top.
3. File completion forms ACO-1 with K.C.C. within 120 days of well spud date, following instructions on ACO-1, side 1, and including copies of wireline logs.
4. Notify District office 48 hours prior to old well workover or re-entry.
5. Prior to filing Intent, prepare a proposed plugging plan in case well is D & A, then obtain approval of plan when calling district office prior to setting surface pipe.
6. Submit plugging report (CP-4) to K.C.C. after plugging is completed.
7. Obtain an approved injection docket number before disposing of salt water.
8. Notify K.C.C. within 10 days when injection commences or terminates.

9. In an alternate 2 completion, cement in the production pipe from below any usable water to surface within 120 days of spud date.

A Regular Section of Land 1 Mile = 5,280 Ft.

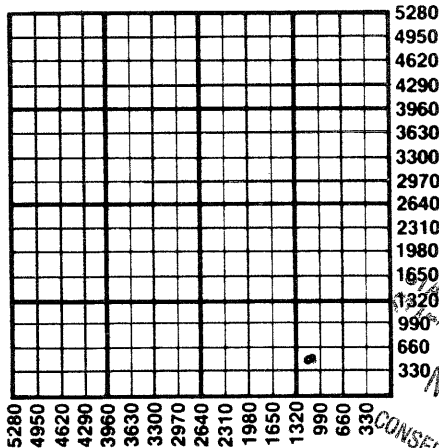

RECEIVED
STATE CORPORATION COMMISSION
WICHITA, KANSAS
NOV 29 1988
CONSERVATION DIVISION
Wichita, Kansas

11-21-88

State Corporation Commission of Kansas
Conservation Division
200 Colorado Derby Building
Wichita, Kansas 67202-1212
(316) 263-3238