

CARD MUST BE SIGNED

Starting Date: October 20, 1984
month day year

API Number 15- 207- 25,092-00-00

OPERATOR: License # 5639
Name Energy Exploration & Production, Inc.
Address 5501 Goxridge Drive
City/State/Zip Mission, Kansas 66202
Contact Person Clay Hedrick, Jr.
Phone 316-283-7911

SE 1/2 SW 1/4 SE/4 Sec 31 Twp 26 S, Rge 16 ☒ East
(location) ☐ West

330 Ft North from Southeast Corner of Section
1320 Ft West from Southeast Corner of Section
(Note: Locate well on Section Plat on reverse side)

Nearest lease or unit boundary line 330
County Woodson feet.

Lease Name Oakes Well# 2

Domestic well within 330 feet : ☐ yes ☒ no

Municipal well within one mile : ☐ yes ☒ no

Depth to Bottom of fresh water 30 feet

Lowest usable water formation feet

Depth to Bottom of usable water 225 250 feet

Surface pipe by Alternate : 1 ☐ 2 ☒

Surface pipe to be set 40 feet

Conductor pipe if any required None feet

Ground surface elevation feet MSL

This Authorization Expires 4-15-85

Approved By 10-15-84 *R*

CONTRACTOR: License # 9960
Name TINNIN BROS. DRILLING
City/State Box 106 Nowata, Okla 74048

Well Drilled For:	Well Class:	Type Equipment:
☐ Oil ☐ Swd	☒ Infield	☒ Mud Rotary
☒ Gas ☐ Inj	☐ Pool Ext.	☐ Air Rotary
☐ OWWO ☐ Expl	☐ Wildcat	☐ Cable

If OWWO: old well info as follows:

Operator

Well Name

Comp Date Old Total Depth

Projected Total Depth 1350 feet

Projected Formation at TD Mississippi

Expected Producing Formations Btlv Sand Mississippi

I certify that we will comply with K.S.A. 55-101, et seq., plus eventually plugging hole to K.C.C. specifications.

Date October 10/84 Signature of Operator or Agent Clay E. Nedrick Title _____

V.P.

Must be filed with the K.C.C. five (5) days prior to commencing well
This card void if drilling not started within six (6) months of date received by K.C.C.


OCT 15 1984

10-15-84

Important procedures to follow :

1. Notify District office before setting surface casing.
2. Set surface casing by circulating cement to the top.
3. File completion forms ACO-1 with K.C.C. within 90 days of well completion, following instructions on ACO-1, side 1, and including copies of wireline logs.
4. Notify District office 48 hours prior to old well workover or re-entry.
5. Prior to plugging, prepare a plugging plan, then obtain agreement from the appropriate district office for an approved plugging plan.
6. Submit plugging report (CP-4) to K.C.C. after plugging is completed.
7. Obtain an approved injection docket number before disposing of salt water.
8. Notify K.C.C. within 10 days when injection commences or terminates.
9. If an alternate 2 completion, cement in the production pipe from below any usable water to surface within 120 days of spud date.

STATE CORPORATION COMMISSION
A Regular Section of Land
1 Mile = 5,280 Ft.

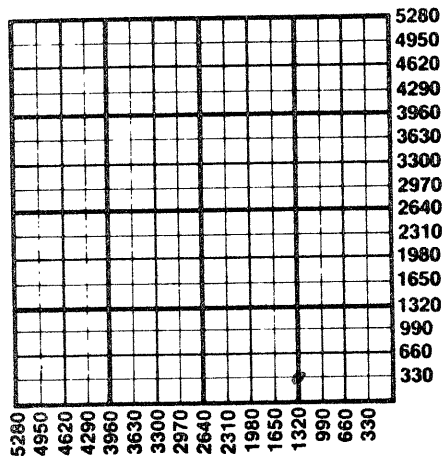

State Corporation Commission of Kansas
Conservation Division
200 Colorado Derby Building
Wichita, Kansas 67202
(316) 263-3238