

CARD MUST BE TYPED

State of Kansas
NOTICE OF INTENTION TO DRILL
(see rules on reverse side)

CARD MUST BE SIGNED

Starting Date: October 20, 1984
month day year

API Number 15- 207-25095-0000

OPERATOR: License # 5639
Name Energy Exploration & Production, Inc.
Address 5501 Foxridge Drive
City/State/Zip Mission, Kansas 66202
Contact Person Clay Hedrick, Jr.
Phone 316-283-7911

NE NE NE Sec 31 Twp 26 S, Rge 16 ☒ East
(location) ☐ West
..... 4950 Ft North from Southeast Corner of Section
..... 330 Ft West from Southeast Corner of Section
(Note: Locate well on Section Plat on reverse side)

CONTRACTOR: License # 9960
Name TINNIN BROS. DRILLING
City/State Box 106 Nowata, Okla. 74048

Nearest lease or unit boundary line 330 feet.
County Woodson
Lease Name Oakes Well # 5

Domestic well within 330 feet: ☐ yes ☒ no
Municipal well within one mile: ☐ yes ☒ no

Well Drilled For: Well Class: Type Equipment:
☐ Oil ☐ Swd ☒ Infield ☒ Mud Rotary
☒ Gas ☐ Inj ☐ Pool Ext. ☐ Air Rotary
☐ OWWO ☐ Expl ☐ Wildcat ☐ Cable

Depth to Bottom of fresh water 30 feet
Lowest usable water formation
Depth to Bottom of usable water 225 250 feet
Surface pipe by Alternate: ☐ 1 ☒ 2
Surface pipe to be set 40 feet
Conductor pipe if any required None feet
Ground surface elevation feet MSL
This Authorization Expires 4-15-85
Approved By 10-15-84 Re

If OWWO: old well info as follows:

Operator
Well Name
Comp Date Old Total Depth
Projected Total Depth 1350 feet
Projected Formation at TD Mississippi
Expected Producing Formations Btlv. Sand Mississippi

I certify that we will comply with K.S.A. 55-101, et seq., plus eventually plugging hole to K.C.C. specifications.

Date Oct. 10/84 Signature of Operator or Agent Clay Hedrick

Title V. P. WAC/KOHE 10/15/84


Must be filed with the K.C.C. five (5) days prior to commencing well
 This card void if drilling not started within six (6) months of date received by K.C.C.
 CONSERVATION DIVISION
 Wichita, Kansas

OCT 15 1984

10-15-84

Important procedures to follow :

STATE CORPORATION COMMISSION
 A Regular Section of Land
 1 Mile - 5,280 Ft.

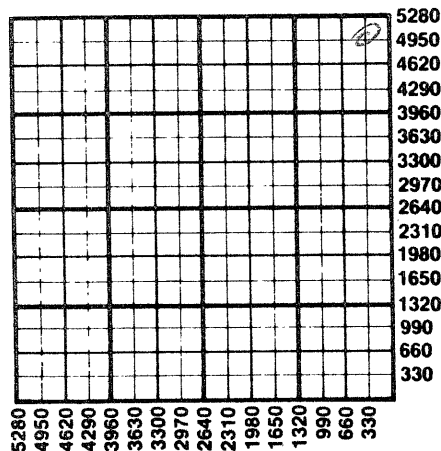

1. Notify District office before setting surface casing.
2. Set surface casing by circulating cement to the top.
3. File completion forms ACO-1 with K.C.C. within 90 days of well completion, following instructions on ACO-1, side 1, and including copies of wireline logs.
4. Notify District office 48 hours prior to old well workover or re-entry.
5. Prior to plugging, prepare a plugging plan, then obtain agreement from the appropriate district office for an approved plugging plan.
6. Submit plugging report (CP-4) to K.C.C. after plugging is completed.
7. Obtain an approved injection docket number before disposing of salt water.
8. Notify K.C.C. within 10 days when injection commences or terminates.
9. If an alternate 2 completion, cement in the production pipe from below any usable water to surface within 120 days of spud date.

State Corporation Commission of Kansas
 Conservation Division
 200 Colorado Derby Building
 Wichita, Kansas 67202
 (316) 263-3238