

CARD MUST BE TYPED

State of Kansas
NOTICE OF INTENTION TO DRILL
(see rules on reverse side)

CARD MUST BE SIGNED

Starting Date: 11 26 84
month day year

API Number 15- 207-25,151-0000

OPERATOR: License # ... 7162
Name ... B. W. Klippel, Jr.
Address ... P. O. Box 11811
City/State/Zip ... Clayton, Missouri 63105
Contact Person ... above
Phone ... 314-721-0500

WL/2 SE1/4 . Sec 16. Twp 26. S, Rge 16. East
(location) West

..... 530 Ft North from Southeast Corner of Section
..... 2520 Ft West from Southeast Corner of Section
(Note: Locate well on Section Plat on reverse side)

CONTRACTOR: License #
Name ... not determined
City/State


Nearest lease or unit boundary line 1320 feet.
County ... Woodson
Lease Name ... Young "B" Well# ... 3

Domestic well within 330 feet : yes no
Municipal well within one mile : yes no

Well Drilled For: **Well Class:** **Type Equipment:**
 Oil Swd Infield Mud Rotary
 Gas Inj Pool Ext. Air Rotary
 OWWO Expl Wildcat Cable

Depth to Bottom of fresh water none feet
Lowest usable water formation none
Depth to Bottom of usable water 250 feet

If OWWO: old well info as follows:
Operator
Well Name
Comp Date Old Total Depth
Projected Total Depth 1200 feet
Projected Formation at TD ... Cattleman ss
Expected Producing Formations ... Cattleman ss

Surface pipe by Alternate : 1 2
Surface pipe to be set 40 feet
Conductor pipe if any required
Ground surface elevation ... 1000± feet MSL
This Authorization Expires ... ~~5-27-85~~ 5-27-85
Approved By ... 11-27-84 

I certify that we will comply with K.S.A. 55-101, et seq., plus eventually plugging hole to K.C.C. specifications.

Date ... 11/26/84 ... Signature of Operator or Agent 

Title ... Owner


**Must be filed with the K.C.C. five (5) days prior to commencing well
This card void if drilling not started within six (6) months of date received by K.C.C.**

**A Regular Section of Land
1 Mile = 5,280 Ft.**

11-27-84

Important procedures to follow :

1. Notify District office before setting surface casing.
2. Set surface casing by circulating cement to the top.
3. File completion forms ACO-1 with K.C.C. within 90 days of well completion, following instructions on ACO-1, side 1, and including copies of wireline logs.
4. Notify District office 48 hours prior to old well workover or re-entry.
5. Prior to plugging, prepare a plugging plan, then obtain agreement from the appropriate district office for an approved plugging plan.
6. Submit plugging report (CP-4) to K.C.C. after plugging is completed.
7. Obtain an approved injection docket number before disposing of salt water.
8. Notify K.C.C. within 10 days when injection commences or terminates.
9. If an alternate 2 completion, cement in the production pipe from below any usable water to surface within 120 days of spud date.

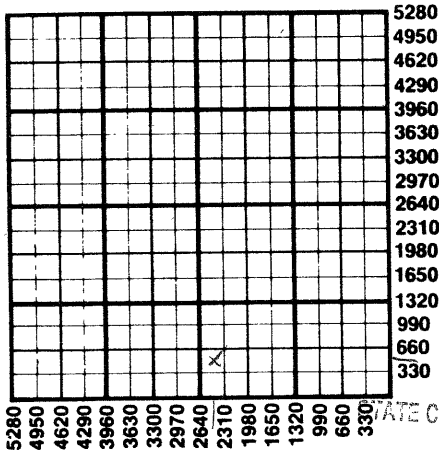

RECEIVED

STATE CORPORATION COMMISSION

**State Corporation Commission of Kansas
Conservation Division
200 Colorado Derby Building
Wichita, Kansas 67202
(316) 263-3238**

NOV 27 1984

CONSERVATION DIVISION
Wichita, Kansas