

CARD MUST BE TYPED

State of Kansas NOTICE OF INTENTION TO DRILL

CARD MUST BE SIGNED

(see rules on reverse side)

Starting Date: 11 26 84
month day year

API Number 15- 207-25,152-00-00

OPERATOR: License # 7162
Name B. W. Klippel, Jr.
Address P. O. Box 11811
City/State/Zip Clayton, Missouri 63105
Contact Person above
Phone 314-721-0500

E1/2 SW1/4 .. Sec 16 .. Twp 26 .. S, Rge 16
(location) East West

2300 Ft North from Southeast Corner of Section
3080 Ft West from Southeast Corner of Section
(Note: Locate well on Section Plat on reverse side)

CONTRACTOR: License #
Name not determined
City/State

Nearest lease or unit boundary line 1320 feet.
County Woodson
Lease Name Young "A" Well# 15

Domestic well within 330 feet : yes no
Municipal well within one mile : yes no

Well Drilled For: Oil Well Class: Type Equipment:
 Oil Swd Infield Mud Rotary
 Gas Inj Pool Ext. Air Rotary
 OWWO Expl Wildcat Cable

Depth to Bottom of fresh water none feet
Lowest usable water formation none
Depth to Bottom of usable water 250 feet

Surface pipe by Alternate : 1 2
Surface pipe to be set 40 feet
Conductor pipe if any required
Ground surface elevation 1000± feet MSL

This Authorization Expires ~~5-20-84~~ 5-27-85
Approved By 11-27-84 R

If OWWO: old well info as follows:

Operator
Well Name
Comp Date Old Total Depth
Projected Total Depth 1200 feet
Projected Formation at TD Cattleman ss
Expected Producing Formations .. Cattleman ss


I certify that we will comply with K.S.A. 55-101, et seq., plus eventually plugging hole to K.C.C. specifications.

Date 11/26/84 Signature of Operator or Agent  Title Owner

Must be filed with the K.C.C. five (5) days prior to commencing well
 This card void if drilling not started within six (6) months of date received by K.C.C.

A Regular Section of Land
 1 Mile = 5,280 Ft.

1-27-84

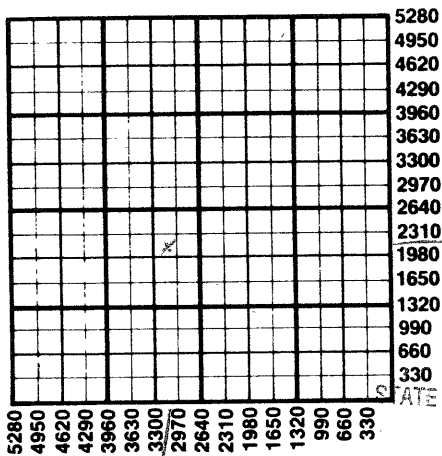

Important procedures to follow :

1. Notify District office before setting surface casing.
2. Set surface casing by circulating cement to the top.
3. File completion forms ACO-1 with K.C.C. within 90 days of well completion, following instructions on ACO-1, side 1, and including copies of wireline logs.
4. Notify District office 48 hours prior to old well workover or re-entry.
5. Prior to plugging, prepare a plugging plan, then obtain agreement from the appropriate district office for an approved plugging plan.
6. Submit plugging report (CP-4) to K.C.C. after plugging is completed.
7. Obtain an approved injection docket number before disposing of salt water.
8. Notify K.C.C. within 10 days when injection commences or terminates.
9. If an alternate 2 completion, cement in the production pipe from below any usable water to surface within 120 days of spud date.

RECEIVED
 STATE CORPORATION COMMISSION

NOV 27 1984

CONSERVATION DIVISION
 Wichita, Kansas

State Corporation Commission of Kansas
 Conservation Division
 200 Colorado Derby Building
 Wichita, Kansas 67202
 (316) 263-3238