

KANSAS CORPORATION COMMISSION  
OIL & GAS CONSERVATION DIVISION  
**WELL PLUGGING APPLICATION**  
Please TYPE Form and File ONE Copy

Form CP-1  
September 2003  
This Form must be Typed  
Form must be Signed  
All blanks must be Filled

API # 15 - 095-00335-00-00 (Identifier Number of this well). This must be listed for wells drilled since 1967; if no API # was issued, indicate original spud or completion date 08-30-59.

Well Operator: Pickrell Drilling Company, Inc. KCC License #: 5123  
(Owner / Company Name) (Operator's)

Address: 100 S. Main, Suite 505 City: Wichita

State: Kansas Zip Code: 67202 Contact Phone: ( 316 ) 262 - 8427

Lease: Reida Well #: 1 Sec. 1 Twp. 30S S. R. 7W  East  West

     -      -      -      Spot Location / QQQQ County: Kingman

2310 Feet (in exact footage) From  North /  South (from nearest outside section corner) Line of Section (Not Lease Line)

4950 Feet (in exact footage) From  East /  West (from nearest outside section corner) Line of Section (Not Lease Line)

Check One:  Oil Well  Gas Well  D&A  Cathodic  Water Supply Well  
 SWD Docket # \_\_\_\_\_  ENHR Docket # \_\_\_\_\_  Other: \_\_\_\_\_

Conductor Casing Size: \_\_\_\_\_ Set at: \_\_\_\_\_ Cemented with: \_\_\_\_\_ Sacks

Surface Casing Size: 8 5/8 Set at: 250 Cemented with: 90 Sacks

Production Casing Size: 5 1/2" Set at: 4199 Cemented with: 95 Sacks

List (ALL) Perforations and Bridgeplug Sets: Perfs. 4125-4135 (See Note)

NOTE: Well squeezed thru holes located 2789-2848 during February, 2006.

Elevation: 1465 ( G.L. /  K.B.) T.D.: 4201 PBTD: 4169 ~~Anhydrite~~ Depth: Heebner 3064 (-1599)  
~~(Close General Formation)~~

Condition of Well:  Good  Poor  Casing Leak  Junk in Hole

Proposed Method of Plugging (attach a separate page if additional space is needed): Plug back with sand to 4075 ft. Use dump bailer to dump 5 sx. cement on top of sand. Cut and recover 5 1/2" casing. Spot cement as required by KCC Representative while coming out of hole and plug top hole as requested.

Is Well Log attached to this application as required?  Yes  No Is ACO-1 filed?  Yes  No

If not explain why? \_\_\_\_\_

Plugging of this Well will be done in accordance with K.S.A. 55-101 et. seq. and the Rules and Regulations of the State Corporation Commission.

List Name of Company Representative authorized to be in charge of plugging operations: \_\_\_\_\_

Deon Howard Phone: ( 620 ) 793 - 2316

Address: 2485 S. State Rd. 14 City / State: Kingman, Kansas 67068-8629

Plugging Contractor: Quality Well Service KCC License #: 31925

Address: 401 West Main, Lyons, Kansas 67554 Phone: ( 620 ) 727 - 3410

Proposed Date and Hour of Plugging (if known?): January 15, 2007

Payment of the Plugging Fee (K.A.R. 82-3-118) will be guaranteed by Operator or Agent

Date: 11-27-06 Authorized Operator / Agent: \_\_\_\_\_

Mail to: KCC - Conservation Division, 130 S. Market - Room 2078, Wichita, Kansas 67202

*Deon Howard*  
(Signature)

RECEIVED  
NOV 28

KCC WICHITA

# KANSAS

CORPORATION COMMISSION

Kathleen Sebelius, Governor    Brian J. Moline, Chair    Robert E. Krehbiel, Commissioner    Michael C. Moffet, Commissioner

## NOTICE OF RECEIPT OF WELL PLUGGING APPLICATION (CP-1)

Pickrell Drilling Company, Inc.  
100 South Main - Suite 505  
Wichita, KS 67202-3738

December 04, 2006

Re: REIDA #1  
API 15-095-00335-00-00  
NWNWSW 1-30S-7W, 2310 FSL 4950 FEL  
KINGMAN COUNTY, KANSAS

Dear Operator:

This letter is to notify you that the Conservation Division is in receipt of your plugging proposal, form CP-1, for the above-captioned well.

Your CP-1 has been reviewed by the Conservation Division central office for completeness and to verify license numbers. The plugging proposal will now be forwarded to the district office listed below for review of your proposed method of plugging.

**Please contact the district office for approval of your proposed plugging method at least five (5) days before plugging the well, pursuant to K.A.R. 82-3-113 (b). If a workover pit will be used during the plugging of the well it must be permitted. A CDP-1 form must be filed and approved prior to the use of the pit.**

The Conservation Division's review of form CP-1, either in the central or district office, does not include an inquiry into well ownership or the filing operator's legal right to plug the well.

**This notice in no way constitutes authorization to plug the above-captioned well by persons not having legal rights of ownership or interest in the well. This notice is void after ninety (90) days from the above date.**

Sincerely




Barry Metz  
Deputy Director

District: #2  
3450 N. Rock Road, Suite 601  
Wichita, KS 67226  
(316) 630-4000

BAKER SERVICE TOOLS - TALLY AND

New Completion     Workover

Oil Company \_\_\_\_\_ Well No. 1 Field \_\_\_\_\_ Lease Reida  
Company Man \_\_\_\_\_ Date Drilled \_\_\_\_\_ County Kingman State Kansas

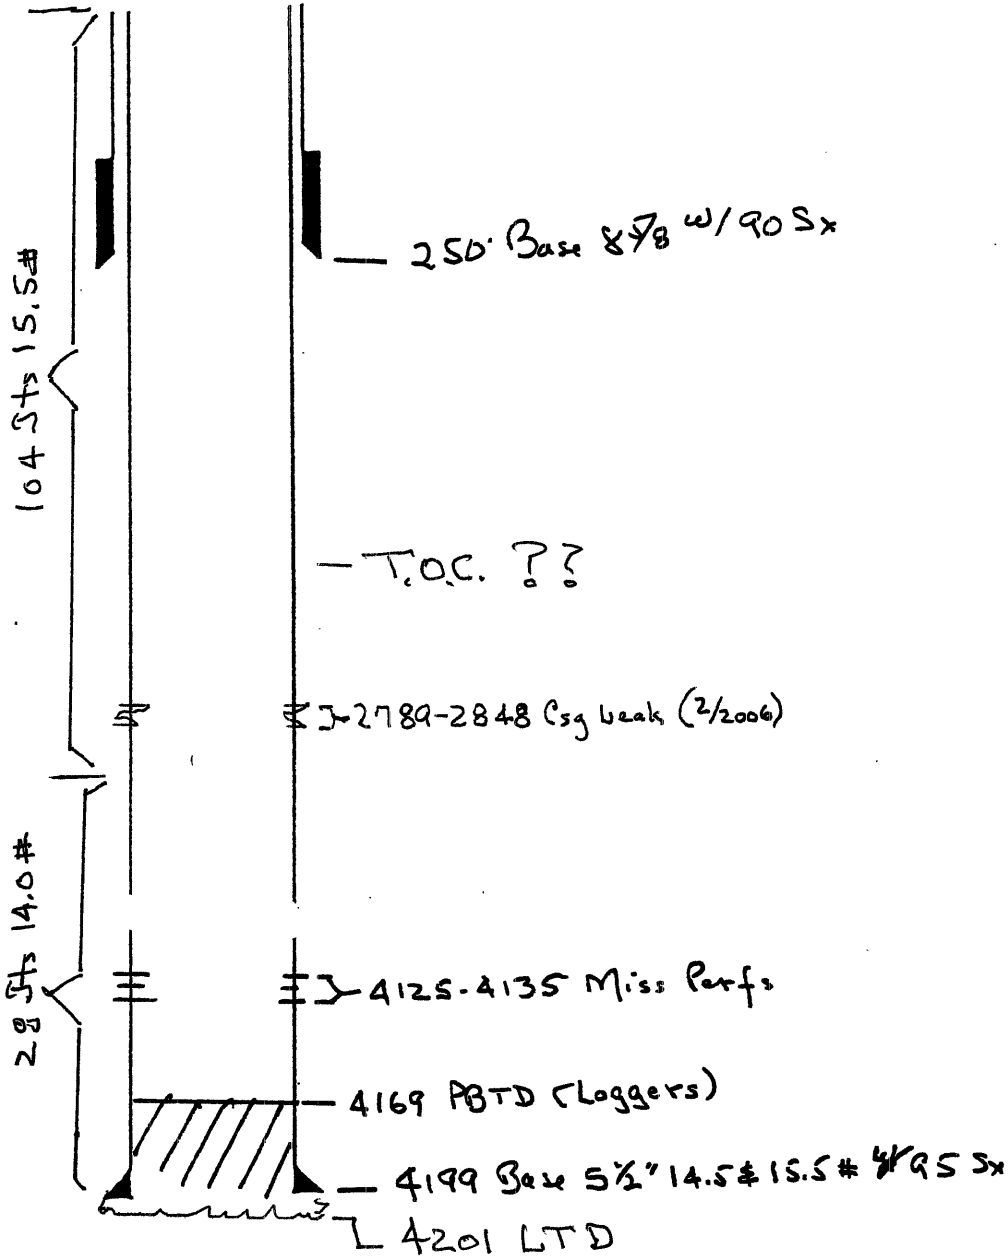

RECEIVED  
NOV 28 2006  
KCC WICHITA