

NOTICE OF INTENTION TO DRILL

(see rules on reverse side)

Starting Date June 21 1985
month day year

API Number 15- 037-21,343-00-00

OPERATOR: License # 5096
Name James E. Russell Petr., Inc.
Address 536 N. Highland
City/State/Zip Chanute, Kansas 66720
Contact Person G. Bob Barnett
Phone 316-431-0755

NW/4 Sec. 30 Twp. 27 S, Rq. 22
3840 Ft. from South Line of Section
4000 Ft. from East Line of Section

(Note: Locate well on Section Plat on reverse side)

CONTRACTOR: License # Unknown
Name
City/State

Nearest lease or unit boundary line 1270 feet

County Crawford

Lease Name Albert Elmer Well # R-1

Ground surface elevation Not Avail. feet MSL

Well Drilled For: Well Class: Type Equipment:
X Oil SWD X Infield X Mud Rotary
Gas Inj Pool Ext. Air Rotary
OWWO Expl Wildcat Cable

Domestic well within 330 feet: yes X no

Municipal well within one mile: yes X no

Surface pipe by Alternate: 1 2 X 3

If OWWO: old well info as follows:
Operator N/A
Well Name
Comp Date Old Total Depth

Depth to bottom of fresh water 100'

Depth to bottom of usable water 100'

Surface pipe planned to be set 20'

Projected Total Depth 665 feet

Formation Tucker


I certify that well will comply with K.S.A. 55-101, et seq., plus eventually plugging hole to KCC specifications. MHC/JOHE 6-24-85

Alternate 3 cementing will be done immediately upon setting production casing.
Date 6-21-85 Signature of Operator or Agent G. Bob Barnett Title General Manager

For KCC Use:
Conductor Pipe Required feet; Minimum Surface Pipe Required feet per Alt. 1 2 3

This Authorization Expires 12-24-85 Approved By 6-24-85

**A Regular Section of Land**  
**1 Mile = 5,280 Ft.**

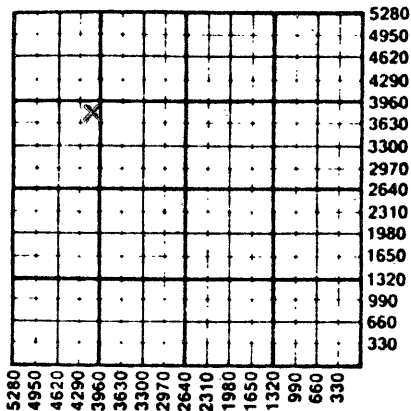

R-1

624-85

important procedures to follow:

1. Notify District office before setting surface casing.
2. Set surface casing by circulating cement to the top.
3. File completion forms ACO-1 with K.C.C. within 90 days of well completion, following instructions on ACO-1, side 1, and including copies of wireline logs.
4. Notify District office 48 hours prior to old well workover or re-entry.
5. Prior to filing Intent, prepare a proposed plugging plan in case well is D & A, then obtain approval of plan when calling district office prior to setting surface pipe.
6. Submit plugging report (CP-4) to K.C.C. after plugging is completed.
7. Obtain an approved injection docket number before disposing of salt water.
8. Notify K.C.C. within 10 days when injection commences or terminates.
9. If an alternate 2 completion, cement in the production pipe from below any usable water to surface within 120 days of spud date.

**State Corporation Commission of Kansas**  
**Conservation Division**  
**200 Colorado Derby Building**  
**Wichita, Kansas 67202**  
**(316) 263-3238**