

Ex. 12-11-84
CARD MUST BE TYPED

State of Kansas
NOTICE OF INTENTION TO DRILL

CARD MUST BE SIGNED
CORRECTION

(see rules on reverse side)

Starting Date: 6 14 84
month day year

"CORRECTION #2"

API Number 15-037-21,169-00-00 62524

OPERATOR: License # 5806

* NW SW Sec 31 Twp 27 S, Rge 24 East
(location)

Name Harold Erbert

Address 2904 N. State

City/State/Zip Topeka, Ks. 66749

Contact Person Kathy Rodabaugh

Phone 316-365-5150

* 1320 Ft North from Southeast Corner of Section
* 5115 Ft West from Southeast Corner of Section
(Note: Locate well on Section Plat on reverse side)

CONTRACTOR: License # 6179

Nearest lease or unit boundary line 165 feet.

County Crawford

Name Bill Frew

Lease Name Kruger Well# 3

City/State Chanute, Ks.

Domestic well within 330 feet: yes no

Municipal well within one mile: yes no

Well Drilled For: Well Class: Type Equipment:

- Oil Swd Infield Mud Rotary
- Gas Inj Pool Ext. Air Rotary
- OWWO Expl Wildcat Cable

Depth to Bottom of fresh water feet

Lowest usable water formation

Depth to Bottom of usable water 100 feet

Surface pipe by Alternate: 1 2

Surface pipe to be set 20 feet

Conductor pipe if any required

Ground surface elevation feet MSL

This Authorization Expires 12-11-84

Approved By G.H. 84

If OWWO: old well info as follows:

Operator

Well Name

Comp Date Old Total Depth

Projected Total Depth 100 feet

Projected Formation at TD Peru

Expected Producing Formations Peru

I certify that we will comply with K.S.A. 55-101, et seq., plus eventually plugging hole to K.C.C. specifications.

Notes: NESESE
825 FSL 495 FEL

Date 6-21-84 Signature of Operator or Agent


Harold Erbert

Title owner

Must be filed with the K.C.C. five (5) days prior to commencing well
 This card void if drilling not started within six (6) months of date received by K.C.C.

6-22-84

A Regular Section of Land
 1 Mile = 5,280 Ft.

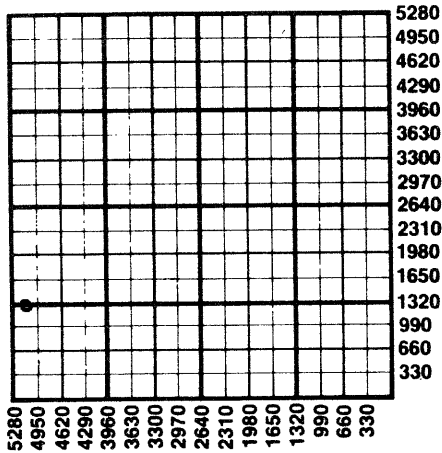

Important procedures to follow:

1. Notify District office before setting surface casing.
2. Set surface casing by circulating cement to the top.
3. File completion forms ACO-1 with K.C.C. within 90 days of well completion, following instructions on ACO-1, side 1, and including copies of wireline logs.
4. Notify District office 48 hours prior to old well workover or re-entry.
5. Prior to plugging, prepare a plugging plan, then obtain agreement from the appropriate district office for an approved plugging plan.
6. Submit plugging report (CP-4) to K.C.C. after plugging is completed.
7. Obtain an approved injection docket number before disposing of salt water.
8. Notify K.C.C. within 10 days when injection commences or terminates.
9. If an alternate 2 completion, cement in the production pipe from below any usable water to surface within 120 days of spud date.

RECEIVED
 STATE CORPORATION COMMISSION

JUN 22 1984

CONSERVATION DIVISION
 Wichita, Kansas

State Corporation Commission of Kansas
 Conservation Division
 200 Colorado Derby Building
 Wichita, Kansas 67202
 (316) 263-3238