

Give All Information Completely
Make Required Affidavit
Mail or Deliver Report to:
Conservation Division
State Corporation Commission
212 North Market, Insurance Bldg.
Wichita, Kansas

WELL PLUGGING RECORD

Rooks County. Sec. 27 Twp. 9 Rge. 18 (E) W (W)

Location as "NE/CNW%SW%" or footage from lines SE SE NW

Lease Owner Nadel and Gussman

Lease Name McConchie Well No. 1

Office Address 1714 First National Bldg. Tulsa 3, Oklahoma

Character of Well (completed as Oil, Gas or Dry Hole) Dry

Date well completed 2-1-19 59

Application for plugging filed 2-1-19 59

Application for plugging approved 2-1-19 59

Plugging commenced 2-1-19 59


Plugging completed 2-1-19 59

Reason for abandonment of well or producing formation Dry

If a producing well is abandoned, date of last production _____ 19____

Was permission obtained from the Conservation Division or its agents before plugging was commenced? Yes

NORTH

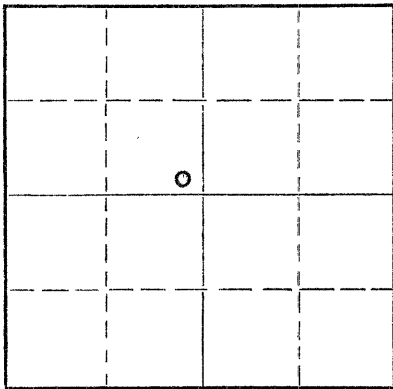

Locate well correctly on above Section Plat

Name of Conservation Agent who supervised plugging of this well _____

Producing formation _____ Depth to top _____ Bottom _____ Total Depth of Well 3635 Feet

Show depth and thickness of all water, oil and gas formations.

OIL, GAS OR WATER RECORDS

CASING RECORD

| FORMATION | CONTENT | FROM | TO | SIZE | PUT IN | PULLED OUT |
|-----------|---------|------|----|-------|--------|------------|
| | | | | 8-5/8 | 260' | 0 |
| | | | | | | |
| | | | | | | |
| | | | | | | |
| | | | | | | |
| | | | | | | |
| | | | | | | |
| | | | | | | |

Describe in detail the manner in which the well was plugged, indicating where the mud fluid was placed and the method or methods used in introducing it into the hole. If cement or other plugs were used, state the character of same and depth placed, from _____ feet to _____ feet for each plug set.

Filled hole with heavy mud from T. D. to 500'

Set plug with 20 sax cement

Set Plug at 240' with 20 sax cement

Set top plug @ 40' with 10 sax cement

(If additional description is necessary, use BACK of this sheet)

Name of Plugging Contractor Reserve Drilling Company, Inc.

Address 625 Union Center, Wichita 2, Kansas

STATE OF KANSAS, COUNTY OF SEDGWICK, ss. E. G. McNeil

(employee of owner) ~~of the above-described well~~ of the above-described well, being first duly sworn on oath, says: That I have knowledge of the facts, statements, and matters herein contained and the log of the above-described well as filed and that the same are true and correct. So help me God.

(Signature) E. G. McNeil

Wichita, Kansas
(Address)

SUBSCRIBED AND SWORN TO before me this 3rd day of February, 1959

My commission expires Nov. 3, 1960

Rola Bush
Notary Public.

RECEIVED
STATE CORPORATION COMMISSION

PLUGGING
FILE SEC. 27 T. 9 R. 18 W
BOOK PAGE 18 LINE 16

3/6/59
MAR 6 1959

CONSERVATION DIVISION
Wichita, Kansas

15-163-00900-00-05

WELL LOG

Nedel and Gussman

McConchie 1

SE SE NW 27-9-18W
Rooks County, Kansas

Comm: 1-24-59

Casing: 8-5/8" 260' w/140 sex

Comp: 2- 1-59

Formations

Depths

Geological Tops

| | | | |
|------------------|------|---------------------|------|
| Shale | 260 | | |
| Shale and shells | 1010 | Heebner | 3308 |
| Sand | 1205 | Toronto | 3329 |
| Shale and shells | 1485 | Lansing-Kansas City | 3349 |
| Anhydrite | 1530 | Base Kansas City | 3556 |
| Shale and shells | 1950 | Conglomerate | 3571 |
| Lime and shale | 2450 | Arbuckle | 3627 |
| Shale | 2675 | | |
| Lime and shale | 3325 | | |
| Lime | 3635 | | |

RECEIVED
 STATE CORPORATION COMMISSION
 3/6/59
 MAR 6 1959
 CONSERVATION DIVISION
 Wichita, Kansas

STATE OF KANSAS }
 COUNTY OF SEDGWICK } SS:

E. G. McNeil, of lawful age, states that the above tops, formations and depths are correct to his best knowledge.

E. G. McNeil
 E. G. McNeil

Subscribed and sworn to before me this 3rd day of February 1959.

John Bush
 Notary Public

My commission expires Nov. 3, 1960

PLUGGING
 FILE SEC 27 9 R 18W
 BOOK PAGE 18 LINE 16