


15-163-00543-00-00

STATE OF KANSAS
STATE CORPORATION COMMISSION

Give All Information Completely
Make Required Affidavit
Mail or Deliver Report to:
Conservation Division
State Corporation Commission
800 Biting Building
Wichita, Kansas

WELL PLUGGING RECORD

NORTH

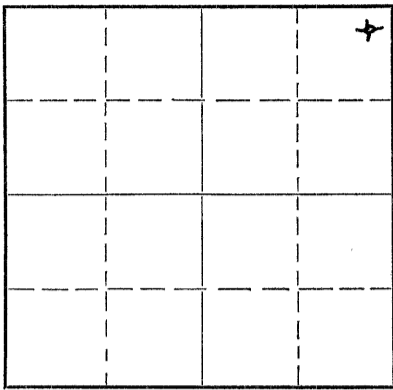

Locate well correctly on above
Section Plat

Location as "NE/CNW $\frac{1}{4}$ /SW $\frac{1}{4}$ " or footage from lines NE NE NE
Lease Owner W. E. Wickizer
Lease Name Collins-Merritt Well No. 1
Office Address WaKeeney, Kansas
Character of Well (completed as Oil, Gas or Dry Hole) Dry Hole
Date well completed July 15, 1953
Application for plugging filed July 15, 1953
Application for plugging approved July 15, 1953
Plugging commenced July 15, 1953
Plugging completed July 15, 1953
Reason for abandonment of well or producing formation Too low

If a producing well is abandoned, date of last production 19
Was permission obtained from the Conservation Division or its agents before plugging was commenced? Yes

Name of Conservation Agent who supervised plugging of this well Mr. Petty
Producing formation None Depth to top 3635 Bottom Total Depth of Well 3635 Feet
Show depth and thickness of all water, oil and gas formations.

OIL, GAS OR WATER RECORDS

CASING RECORD

Formation	Content	From	To	Size	Put In	Pulled Out
				8-5/8"	151'	

Describe in detail the manner in which the well was plugged, indicating where the mud fluid was placed and the method or methods used in introducing it into the hole. If cement or other plugs were used, state the character of same and depth placed, from feet to feet for each plug set.

Bottom plug: 145 ft. $\frac{1}{2}$ sack hulls, 15 sacks cement

Top plug: 40 ft. $\frac{1}{2}$ sack hulls, 10 sacks cement

Filled hole with mud between plugs.

(If additional description is necessary, use BACK of this sheet)

Correspondence regarding this well should be addressed to W. E. Wickizer
Address WaKeeney, Kansas

STATE OF Kansas, COUNTY OF Rooks, ss.
I, W. E. Wickizer (employee of owner) or (owner or operator) of the above-described well,

being first duly sworn on oath, says: That I have knowledge of the facts, statements, and matters herein contained and the log of the above-described well as filed and that the same are true and correct. So help me God.

(Signature) W. E. Wickizer
WaKeeney, Ks (Address)

SUBSCRIBED AND SWORN to before me this 17th day of July, 1953

My commission expires Sept. 10, 1955

23-3273-s 4-50-10M

RECEIVED
STATE CORPORATION COMMISSION
7/20/53
JUL 20 1953
Notary Public.

CONSERVATION DIVISION
Wichita, Kansas

PLUGGING
FILE SEC 27T 9 R 180
BOOK PAGE 115 LINE 38

15-163-00543-00-00

W.H. Wickizer

Sec 27 Twp 9s Rge 18w
Location NE NE NE

Collins farm No 1

Total Depth 3635
Comm 7-5-53 Comp 7-15-53
Contr. Golden Cat Drilling Co.

Casing 8 5/8 " 154ft

Heavy Shale Shells	154-1275
Shale & Redbed	1275-1528
Anhydrite	1528-1545 -1661
Shale	1661-1855 -2066
Salt Shale shells	2066-2187
Shale	2187-2320
Shale Brecken Lime	2320-2420
Shale & Lime	2420-2715
Lime & Shale	2715-2755
Shale & Shells	2755-2910
Shale & Lime	2910-3215
Lime	3215-3400
Lime	3400-3612
Gong	3612-3625

PLUGGING
 FILE NO. 27 T 9 R 18W
 DATE 7/22/53
 PAGE 16 LINE 28
 STATE COMMISSION
 CONFIRMATION DIVISION
 Wichita, Kansas

Hi! Speck:- Paul and I drilled this one by our
 selves. Cold Cats failed us.
 Hick