


STATE OF KANSAS
STATE CORPORATION COMMISSION

Give All Information Completely
Make Required Affidavit
Mail or Deliver Report to:
Conservation Division
State Corporation Commission
212 North Market, Insurance Bldg.
Wichita, Kansas

WELL PLUGGING RECORD

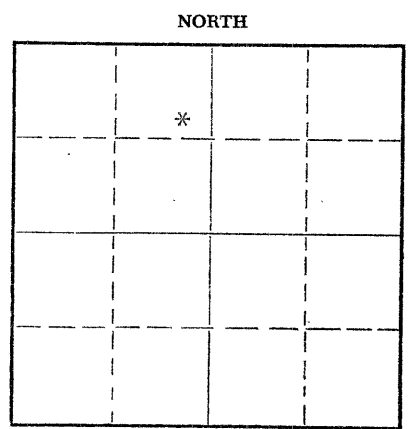

Locate well correctly on above
Section Plat

Rooks _____ County. Sec. 18 Twp. 9S Rge. 18 (E)W (W)
Location as "NE/CNW/SW" or footage from lines _____ SE NE NW
Lease Owner Robinowitz Oil Company
Lease Name Bedard Well No. 1
Office Address 311 Shell Building, Tulsa, Oklahoma
Character of Well (completed as Oil, Gas or Dry Hole) Dry Hole
Date well completed _____ 9-19 1960
Application for plugging filed _____ 9-19 1960
Application for plugging approved _____ 9-19 1960
Plugging commenced 3:00 A.M. _____ 9-20 1960
Plugging completed _____ 9-20 1960
Reason for abandonment of well or producing formation Dry Hole

If a producing well is abandoned, date of last production _____ 19____
Was permission obtained from the Conservation Division or its agents before plugging was commenced? Yes

Name of Conservation Agent who supervised plugging of this well Eldon Petty
Producing formation _____ Depth to top _____ Bottom _____ Total Depth of Well 3553 Feet
Show depth and thickness of all water, oil and gas formations.


OIL, GAS OR WATER RECORDS

CASING RECORD

FORMATION	CONTENT	FROM	TO	SIZE	PUT IN	PULLED OUT
Surface Pipe		-0-	212	8 5/8"	212'	-0-

Describe in detail the manner in which the well was plugged, indicating where the mud fluid was placed and the method or methods used in introducing it into the hole. If cement or other plugs were used, state the character of same and depth placed, from _____ feet to _____ feet for each plug set.

Filled hole with heavy mud.
Set plug at 550' with 1/4 sack hulls on top & 20 sacks cement through drill pipe.
Filled hole with heavy mud to 180'.
Set plug at 180' with 1/4 sack hulls & 20 sacks cement on top through drill pipe.
Set plug at 30' with 10 sacks cement

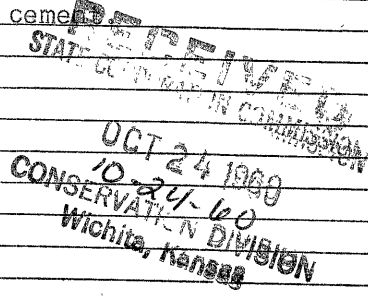

(If additional description is necessary, use BACK of this sheet)
Name of Plugging Contractor A. L. Jackson Drilling Company
Address Box 194, Great Bend, Kansas

STATE OF KANSAS, COUNTY OF BARTON, ss.
C. L. Miles, contractor on _____ (employee of owner) or (owner or operator) of the above-described well, being first duly sworn on oath, says: That I have knowledge of the facts, statements, and matters herein contained and the log of the above-described well as filed and that the same are true and correct. So help me God.
(Signature) C. L. Miles

Box 194 Great Bend, Ks.
(Address)
SUBSCRIBED AND SWORN TO before me this 27th day of September, 1960

My commission expires 12-3-63
Jean Kemler
Notary Public.



W E L L L O G
 Bedard # 1
 SE NE NW 18-9S-18W
Rooks County, Kansas

		<u>Elevation</u>	<u>2094 D. F.</u>
0 - 40	Post rock & clay		
40 - 820	Shale & shales		<u>Formation Tops</u>
820 - 980	Shale		
980 - 1050	Sand and shales	Anhydrite	1493
1050 - 1375	Shale, red bed	Topeka	3040
1375 - 1483	Red bed	Heebner	3247
1483 - 1530	Anhydrite	Toronto	3270
1530 - 1635	Shale	Kansas City	3290
1635 - 1880	Shale & Shells	Base - Kansas City	3509
1880 - 2210	Shale	Arbuckle	3534
2210 - 2290	Lime - broken - shale	T. D.	3553
2290 - 3045	Lime & Shale		
3045 - 3553	Lime		
3553	T. D.		

STATE OF KANSAS

COUNTY OF BARTON ss

C. L. Miles, d/b/a A. L. Jackson Drilling Company, being first duly sworn on oath says: That I have knowledge of the facts, statements and matters herein contained and the log of the above described well as filed and that the same are true and correct.

C. L. Miles

 C. L. Miles

Subscribed and sworn before me this 27th day of September, 1960.

Jean Kimber

 Notary Public--Barton County

My Commission Expires: December 3, 1963.

RECORDED
 STATE OF KANSAS
 OCT 2 1960
 CC