

STATE OF KANSAS
STATE CORPORATION COMMISSION

Give All Information Completely
Make Required Affidavit
Mail Deliver Report to:
Conservation Division
State Corporation Commission
1001 No. Broadway
Wichita, Kansas

WELL PLUGGING RECORD

Rooks County, Sec. 18 Twp. 9S Rge. (E) 18 (W)

Location as "NE/CNW/SW" or footage from lines NE SE SE

Lease Owner Chief Drilling Co., Inc.

Lease Name WILKENSON Well No. 1

Office Address Box 797 - Great Bend, Kansas

Character of Well (completed as Oil, Gas or Dry Hole) Dry Hole

Date well completed 2/3 1963

Application for plugging filed 2/3 1963

Application for plugging approved 2/3 1963


Plugging commenced 2/3 1963

Plugging completed 2/3 1963

Reason for abandonment of well or producing formation Dry Hole

If a producing well is abandoned, date of last production 19

Was permission obtained from the Conservation Division or its agents before plugging was commenced? Yes

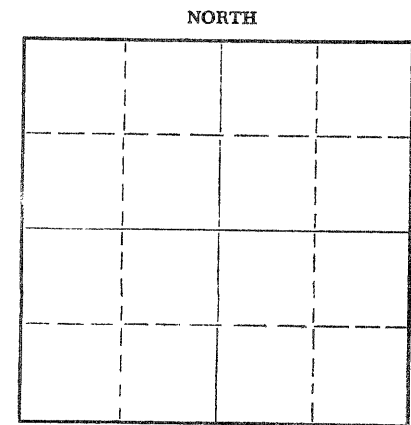

Locate well correctly on above Section Plat

Name of Conservation Agent who supervised plugging of this well Eldon Petty

Producing formation Depth to top Bottom Total Depth of Well 3435 Feet

Show depth and thickness of all water, oil and gas formations.

OIL, GAS OR WATER RECORDS

CASING RECORD

FORMATION	CONTENT	FROM	TO	SIZE	PUT IN	PULLED OUT
		0	201	8 5/8"	201	None

Describe in detail the manner in which the well was plugged, indicating where the mud fluid was placed and the method or methods used in introducing it into the hole. If cement or other plugs were used, state the character of same and depth placed, from feet to feet for each plug set.

- 1 wooden plug set @ 540'
- Mixed 20 sacks cement thru drill pipe
- 1/3 sx hulls and wooden plug set @ 180'
- Mixed 20 sx cement thru drill pipe
- 1/3 sx hulls and wooden plug set @ 40'
- Mixed 10 sacks cement thru drill pipe

RECEIVED
STATE CORPORATION COMMISSION
FEB 8 1963
2-8-63
CONSERVATION DIVISION
Wichita, Kansas

Name of Plugging Contractor Chief Drilling Co., Inc.
Address Box 797 - Great Bend, Kansas

STATE OF Kansas, COUNTY OF Barton, ss.

V. Richard Hoover, President (employee of owner) or (owner or operator) of the above-described well, being first duly sworn on oath, says: That I have knowledge of the facts, statements, and matters herein contained and the log of the above-described well as filed and that the same are true and correct. So help me God. CHIEF DRILLING CO., INC.

(Signature) Richard Hoover
Box 797 - Great Bend, Kansas

SUBSCRIBED AND SWORN TO before me this 4th day of February 1963

My commission expires Jan. 26, 1967

(Address)
Carmen R. Cook
Carmen R. Cook Notary Public



WELL LOG

Chief Drilling Co., Inc.
Box 797
Great Bend, Kansas

WILKENSON #1
NE SE SE Sec. 18-9S-18W
Rooks County, Kansas

Contractor: Chief Drilling Co., Inc. Commenced: 1-29-63
Completed: 2-3-63

Casing Record: 8-5/8" @ 201' w/140 sacks Sunset Cement.

<u>FORMATION</u>	<u>FROM</u>	<u>TO</u>	<u>ELEVATION</u>
Sand & Shells	0	1190	2171 Gr.
Sand	1190	1320	2173 D.F.
Shale & Redbed	1320	1582	2176 K.B.
Anhydrite	1582	1632	
Shale & Shells	1632	2025	
Shale & Lime	2025	2455	
Lime	2455	2465	
Lime & Shale	2465	3123	
Lime	3123	3435	
Total Depth	3425		

<u>FORMATION TOPS</u>	
Anhydrite	1582 + 594
Topeka	3123 - 947
Heebner	3333 - 1157
Toronto	3353 - 1177
Lansing	3372 - 1196
Total Depth	3435 - 1259

STATE OF KANSAS, COUNTY OF BARTON) SS

I hereby certify that the above is a true and correct copy of the Driller's Log of the well drilled in the NE SE SE Sec. 18-9S-18W, Rooks County, Kansas, to the best of my knowledge and belief.

CHIEF DRILLING CO., INC.

V. Richard Hoover
V. Richard Hoover, President

Subscribed and sworn to before me this 6th day of February, 1963.

Carmen R. Cook
Carmen R. Cook, Notary Public

My commission expires: Jan. 26, 1967.

RECEIVED
STATE CORPORATION COMMISSION
2-8-63
FEB 8 1963

CONSERVATION DIVISION
Wichita, Kansas