


STATE OF KANSAS
STATE CORPORATION COMMISSION

WELL PLUGGING RECORD

Give All Information Completely
Make Required Affidavit
Mail or Deliver Report to
Conservation Division
State Corporation Comm.
245 North Water
Wichita, KS 67202

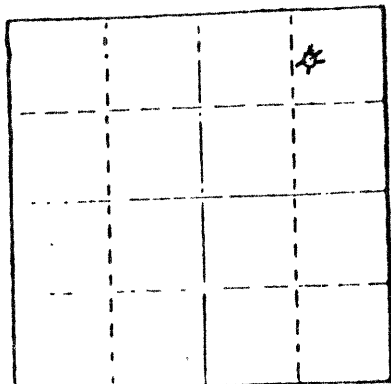

Rooks _____ County. Sec. 18 Twp. 9S Rge. 18 E/W
Location as "NE/CNW/SW" or footage from lines _____
C W/2 NE NE
Lease Owner The National Oil Company
Lease Name Peck Well No. #1
Office Address 200 W Douglas, Suite 550, Wichita, Ks. 67202
Character of Well (Completed as Oil, Gas or Dry Hole) _____

Dry Hole
Date Well completed March 26, 1980
Application for plugging filed March 26, 1980
Application for plugging approved March 26, 1980
Plugging commenced March 26, 1:30 A.M. 1980
Plugging completed March 26, 3:00 A.M. 1980
Reason for abandonment of well or producing formation _____
No Commercial Production

If a producing well is abandoned, date of last production 19
Was permission obtained from the Conservation Division or its agents before plugging was commenced? yes

Name of Conservation Agent who supervised plugging of this well Marion Schmidt
Producing formation _____ Depth to top _____ Bottom _____ Total Depth of Well _____
Show depth and thickness of all water, oil and gas formations.

OIL, GAS OR WATER RECORDS

CASING RECORD

FORMATION	CONTENT	FROM	TO	SIZE	PUT IN	PULLED OUT
Surface casing	common	0'	198.39	8 5/8"	198.39'	0

Describe in detail the manner in which the well was plugged, indicating where the mud flu was placed and the method or methods used in introducing it into the hold. If cement or other plugs were used, state the character of same and depth placed, from _____ feet to _____ feet for each plug set.

- Plug #1 @ 760' with 70 sxs
- Plug #2 @ 180' with 20 sxs
- Plug #3 @ 40' with 10 sxs, 1 sx hulls, 6% gel, solid bridge
- rat hole with 5 sxs
- Plugdown @ 3:00 A.M.

(If additional description is necessary, use BACK of this sheet)

Name of Plugging Contractor Pioneer Drilling Company, Inc.
308 West Mill Plainville, Kansas 67663

X STATE OF KANSAS COUNTY OF SEDGWICK, ss.
Bill C. Romig (employee of owner) or (owner or operator)
of the above-described well, being first duly sworn on oath, says: That I have knowledge of the facts, statements, and matters herein contained and the log of the above-described well as filed and that the same are true and correct. So help me God.

(Signature) Bill C. Romig
200 W. Douglas, Suite 800, Wichita, K (Address) 67202

SUBSCRIBED AND SWORN TO before me this 31st day of March, 1980

Tammy L. Fahnholz
Tammy L. Fahnholz Notary Public.

My commission expires 2/8/83

