

WELL PLUGGING RECORD

Give All Information Completely
Make Required Affidavit
Mail or Deliver Report to:
Conservation Division
State Corporation Commission
212 No. Market
Wichita, Kansas

Rooks County, Sec. 8 Twp. 9S Rge. (E) 18 (W)

Location as "NE/CNW/SW" or footage from lines C E 1/2 NW NW

Lease Owner Rains & Williamson Oil Co., Inc.

Lease Name HILGERS Well No. 2

Office Address 1425 Wichita Plaza - Wichita, Kansas 67202

Character of Well (completed as Oil, Gas or Dry Hole) Dry Hole

Date well completed 6-11 19 67

Application for plugging filed 6-11 19 67

Application for plugging approved 6-11 19 67


Plugging commenced 6-11 19 67

Plugging completed 6-11 19 67

Reason for abandonment of well or producing formation No oil or gas found
in commercial quantities

If a producing well is abandoned, date of last production -- 19 --

Was permission obtained from the Conservation Division or its agents before plugging was commenced? Yes

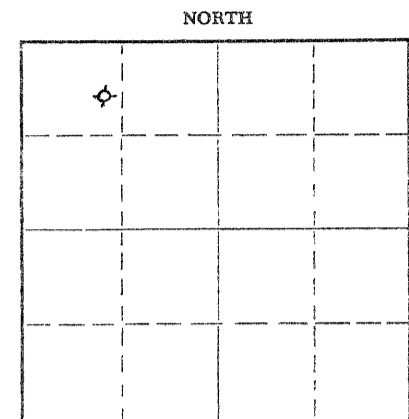

Locate well correctly on above Section Plat

Name of Conservation Agent who supervised plugging of this well Leo Massey, Hays, Kansas

Producing formation None Depth to top Bottom Total Depth of Well 3583 Feet

Show depth and thickness of all water, oil and gas formations.

OIL, GAS OR WATER RECORDS

CASING RECORD

FORMATION	CONTENT	FROM	TO	SIZE	PUT IN	PULLED OUT
				8-5/8"	209.36'	None

Describe in detail the manner in which the well was plugged, indicating where the mud fluid was placed and the method or methods used in introducing it into the hole. If cement or other plugs were used, state the character of same and depth placed, from feet to feet for each plug set.

Pushed plug to 500'. Spotted 25 sacks cement. Mud back to 200'.
Pushed plug and spot w/20 sacks cement. Mud back to 40'. Set
solid bridge and capped with 8 sacks, 2 sacks in rat hole. Plug-
ging completed at 4:00 P.M., 6-11-67.

RECEIVED
STATE CORPORATION COMMISSION
6/14/67
JUN 14 1967

CONSERVATION DIVISION
Wichita, Kansas

(If additional description is necessary, use BACK of this sheet)
Name of Plugging Contractor Rains & Williamson Oil Co., Inc.
Address 1425 Wichita Plaza - Wichita, Kansas

STATE OF KANSAS, COUNTY OF SEDGWICK, ss.
Wilson Rains

(owner or operator) of the above-described well, being first duly sworn on oath, says: That I have knowledge of the facts, statements, and matters herein contained and the log of the above-described well as filed and that the same are true and correct. So help me God.

(Signature) Wilson Rains Wilson Rains
1425 Wichita Plaza - Wichita, Kansas
(Address)

SUBSCRIBED AND SWORN TO before me this 13 day of June, 19 67

My commission expires March 3, 1970
Mary J. Brown Notary Public.

15-163-20028-00-06

ROTARY DRILLING LOG

Operator: Rains & Williamson Oil Co.,
Inc.
HILGERS #2
C E 1/2 NW NW Sec. 8-9S-18W
Rooks County, Kansas

Contractor: Rains & William-
son Oil Co., Inc.
Commenced: 6-4-67
Completed: 6-11-67

Remarks: Set 8-5/8" surface
casing at 209.36',
cemented w/150 sx.
GL-3 cement.

Formations

Clay and Sand	40'
Shale	260'
Sand	1170'
Shale	1315'
Shale and Red Bed	1445'
Anhydrite	1491'
Shale	1950'
Lime and Shale	2680'
Shale and Lime	3005'
Lime and Shale	3175'
Lime	3510'
Lime and Chert	3583'
Rotary Total Depth (D & A)	3583'

RECEIVED
STATE CORPORATION COMMISSION
6/14/67
JUN 14 1967


CONSERVATION DIVISION
Wichita, Kansas

We certify the above log is
true and correct to the best
of our knowledge and belief.

RAINS & WILLIAMSON OIL CO., INC.


Wilson Rains

Subscribed and sworn to before me, a Notary Public in and for the State of
Kansas, County of Sedgwick, this 13th day of June, 1967.


Mary J. Brown Notary Public

My Commission Expires:
March 3, 1970