


15-163-03464-00-00

STATE OF KANSAS
STATE CORPORATION COMMISSION

WELL PLUGGING RECORD

Give All Information Completely
Make Required Affidavit
Mail or Deliver Report to:
Conservation Division
State Corporation Commission
800 Biting Building
Wichita, Kansas

Rooks County. Sec. 8 Twp. 9 Rge. 18 (W)
Location as "NE/CNW $\frac{1}{4}$ SW $\frac{1}{4}$ " or footage from lines NW $\frac{1}{4}$ SW $\frac{1}{4}$ SE $\frac{1}{4}$
Lease Owner Brunson Drilling Company, Inc. et al
Lease Name Elizabeth Hilgers Well No. 1
Office Address
Character of Well (completed as Oil, Gas or Dry Hole) Dry
Date well completed 5/10 19 49
Application for plugging filed 5/10 19 49
Application for plugging approved 5/10 19 49
Plugging commenced 5/10 19 49
Plugging completed 5/10 19 49
Reason for abandonment of well or producing formation Dry

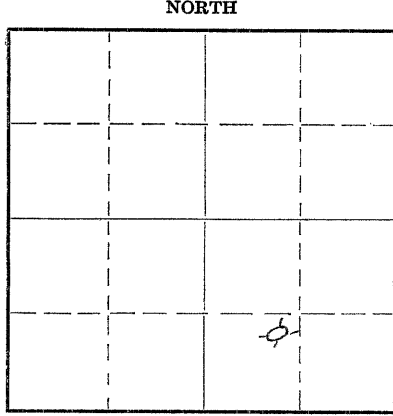

Locate well correctly on above
Section Plat

If a producing well is abandoned, date of last production 19
Was permission obtained from the Conservation Division or its agents before plugging was commenced? Yes

Name of Conservation Agent who supervised plugging of this well C. D. Stough
Producing formation Depth to top Bottom Total Depth of Well 3525 Feet
Show depth and thickness of all water, oil and gas formations.


OIL, GAS OR WATER RECORDS

CASING RECORD

Formation	Content	From	To	Size	Put In	Pulled Out
				8 $\frac{3}{8}$	195	

Describe in detail the manner in which the well was plugged, indicating where the mud fluid was placed and the method or methods used in introducing it into the hole. If cement or other plugs were used, state the character of same and depth placed, from feet to feet for each plug set.

Filled hole with heavy mud to 200 feet. Set wooden plug at 200 feet.
Mixed and dumped 15 sacks of cement on plug. Filled hole with heavy mud to 25 feet. Set wooden plug. Mixed and dumped 10 sacks of cement on plug.

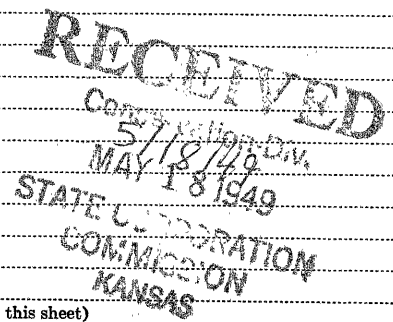

(If additional description is necessary, use BACK of this sheet)

Correspondence regarding this well should be addressed to Brunson Drilling Company, Inc.
Address 302-304 Central Building; Wichita, Kansas

STATE OF Kansas, COUNTY OF Sedgwick, ss.
William S. Brunson (employee of owner) or (owner or operator) of the above-described well, being first duly sworn on oath, says: That I have knowledge of the facts, statements, and matters herein contained and the log of the above-described well as filed and that the same are true and correct. So help me God. BRUNSON DRILLING COMPANY, Inc.
(Signature) William S. Brunson
302 Central Building; Wichita, Kansas (Address)

SUBSCRIBED AND SWORN TO before me this 17 day of May, 1949
Ralph B. McLaughlin Notary Public

PLUGGING
8 19 18
96 44

15-163-03464-00-00

BRUNSON DRILLING COMPANY, Inc.

WICHITA, KANSAS

Well: Hilgers #1

NW/4 SW/4 SE/4 Sec. 8-9-18
Rooks County, Kansas

Commenced RD: 5/1/1949
Completed RD: 5/10/1949
Total Depth : 3525'

Elevation : 2069' D.F.
Initial Prod: Dry
Contractor : Brunson Drilling Co., Inc.

Casing: Set 195' 8 5/8" 8rd thd 28#

STRATA	DEPTH		
Surface soil & rock	65		
Shale & rock	376		
Shale & shells	800		
Sand & shale	1230		
Redbed & shale	1441		
Anhydrite	1984		
Redbed & shale	1885		
Salt & shale	2055		
Shale & shells	2445		
Broken lime	2750		
Shale & shells	2810		
Broken lime	2926		
Shale & shells	3065		
Shale & lime	3130		
Broken lime	3269		
Lime & shale	3292		
Lime	3490		
Lime & shale	3510		
Conglomerate	3525		
Total Depth	3525		

T O P S

Heebner 3218'
Lansing 3255'
Conglomerate 3508'

I hereby certify that the above is a true and correct log of said well as reflected by the daily drilling reports.

BRUNSON DRILLING COMPANY, Inc.
By

William S. Brunson
Wm. S. Brunson Sec.

Signed and sworn to in my presence this 16th day of May, 1949, by Wm. S. Brunson, secretary of the Brunson Drilling Company, Inc., a corporation in the State of Kansas.

Ralph B. McLaughlin
Notary Public

My commission expires April 12, 1952.

PLUGGING
WELL SEC. 8-9-18w
BOOK PAGE 96 LINE 44