

Give All Information Completely
Make Required Affidavit
Mail or Deliver Report to:
Conservation Division
State Corporation Commission
212 North Market, Insurance Bldg.
Wichita, Kansas


WELL PLUGGING RECORD

15-163-00783-00-00

Rooks County, Sec. 8 Twp. 8 Rge. 18W (E) (W)

Location as "NE/CNW%SW%" or footage from lines SW NE NW
Lease Owner Olympic Petroleum Co.
Lease Name Hilgers Well No. 1
Office Address 204 Columbia Building, Wichita, Kansas
Character of Well (completed as Oil, Gas or Dry Hole) Dry hole
Date well completed Nov. 17 19 60
Application for plugging filed Nov. 17 19 60
Application for plugging approved Nov. 17 19 60
Plugging commenced 6 P.M. Nov. 17 19 60
Plugging completed 9 P.M. Nov. 17 19 60
Reason for abandonment of well or producing formation dry hole

NORTH

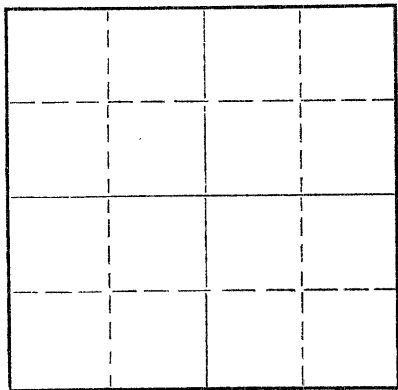

Locate well correctly on above Section Plat

If a producing well is abandoned, date of last production _____ 19____
Was permission obtained from the Conservation Division or its agents before plugging was commenced? yes

Name of Conservation Agent who supervised plugging of this well A. D. Fabricius
Producing formation _____ Depth to top _____ Bottom _____ Total Depth of Well 3520 Feet
Show depth and thickness of all water, oil and gas formations.

OIL, GAS OR WATER RECORDS

CASING RECORD

FORMATION	CONTENT	FROM	TO	SIZE	PUT IN	PULLED OUT
				8-5/8"	204'	None

Describe in detail the manner in which the well was plugged, indicating where the mud fluid was placed and the method or methods used in introducing it into the hole. If cement or other plugs were used, state the character of same and depth placed, from _____ feet to _____ feet for each plug set.

Bottom plug set at 400' w/20 sacks common cement
Middle plug set at 200' w/20 sacks common cement
Top plug set at 40' w/10 sacks common cement

Protects all known water zones

(If additional description is necessary, use BACK of this sheet)


Name of Plugging Contractor Tomlinson-Kathol, Inc.
Address 414 Union Center, Wichita, Kansas

STATE OF Kansas COUNTY OF Sedgwick, ss.
Gerald J. Kathol (employee of owner) or (owner or operator) of the above-described well, being first duly sworn on oath, says: That I have knowledge of the facts, statements, and matters herein contained and the log of the above-described well as filed and that the same are true and correct. So help me God.

(Signature) Gerald J. Kathol
Gerald J. Kathol
414 Union Center, Wichita, Kansas
(Address)

SUBSCRIBED AND SWORN TO before me this 22nd day of November, 19 60

My commission expires 1/19/60
Esther Lamotte Notary Public.

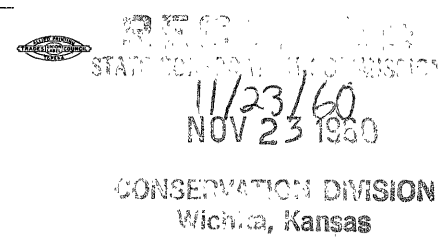

DRILLERS LOG
OLYMPIC PETROLEUM CO.
1 HILGERS
SW NE NW, SEC. 8-9S-18W
ROOKS COUNTY, KANSAS

Contractor - Tomlinson-Kathol, Inc.

Commenced: 11/5/60
Completed: 11/17/60
Elevation: 2060 RB

<u>From</u>	<u>To</u>	<u>Description</u>	<u>Remarks</u>
0	100	Clay	
100	160	Shale	
160	204	Blue Shale	
204	580	Shale	
580	640	Shale & Chalk Lime	
640	854	Shale & Red Bed	
854	930	Shale	
930	1090	Dakota Sand	
1090	1520	Shale	
1520	1700	Shale & Red Bed	
1700	1800	Lime & Shale	
1800	2923	Shale	
2923	3103	Shale & Lime	
3103	3249	Lime & Shale	
3249	3487	Lime	
3487	3493	Arbuckle	
3493	3520	Shale, Lime & Chert	
3520		Total Depth	
			<i>Tops</i>
		Topeka	2989
		Heebner	3196
		Toronto	3216
		Lansing	3235
		Kansas City	3442
		Arbuckle	3481

I certify to the best of my knowledge and belief, the above represents a true and accurate Driller's Log record of the captioned well.

Gerald J. Kathol
Gerald J. Kathol

State of Kansas)
County of Sedgwick)

Subscribed and sworn to before me this 22nd day of November, 1960.

Esther Lamone
Esther Lamone, Notary Public

My Commission Expires: 1/19/61

11/23/60
NOV 23 1960
CONSERVATION DIVISION
Wichita, Kansas