


15-163-19282-00-00

STATE OF KANSAS
STATE CORPORATION COMMISSION

Give All Information Completely
Make Required Affidavit
Mail or Deliver Report to:
Conservation Division
State Corporation Commission
800 Bittling Building
Wichita, Kansas

WELL PLUGGING RECORD

NORTH

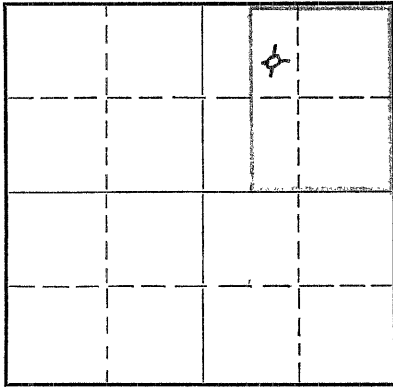

Locate well correctly on above
Section Plat

Rooks _____ County. Sec. 7 Twp. 9S Rge. 18 ~~XXK~~ (W)
Location as "NE/CNW $\frac{1}{4}$ SW $\frac{1}{4}$ " or footage from lines CEL NW/4 NE/4
Lease Owner B - H - P
Lease Name Werner Well No. 1
Office Address P. O. Box 62, Great Bend, Kansas
Character of Well (completed as Oil, Gas or Dry Hole) Dry Hole
Date well completed November 21 19 50
Application for plugging filed November 21 19 50
Application for plugging approved November 22 19 50
Plugging commenced November 21 19 50
Plugging completed November 21 19 50
Reason for abandonment of well or producing formation
Dry
If a producing well is abandoned, date of last production _____ 19 ____
Was permission obtained from the Conservation Division or its agents before plugging was commenced? _____

Name of Conservation Agent who supervised plugging of this well Eldon Petty
Producing formation _____ Depth to top _____ Bottom _____ Total Depth of Well 3621 Feet
Show depth and thickness of all water, oil and gas formations.

OIL, GAS OR WATER RECORDS

CASING RECORD

Formation	Content	From	To	Size	Put In	Pulled Out
				8-5/8"	200'	X

Describe in detail the manner in which the well was plugged, indicating where the mud fluid was placed and the method or methods used in introducing it into the hole. If cement or other plugs were used, state the character of same and depth placed, from 3621 feet to 0 feet for each plug set.

Filled hole with heavy mud; pushed bottom plug to 195'; cemented with 15 sacks of cement; pushed top plug to 35 ftt. of bottom of cellar; cemented with 10 sacks of cement.

Received
STATE CORP. COM.
11/25/50
NOV 25 1950
CONSERVATION DIVISION
Wichita, Kansas

(If additional description is necessary, use BACK of this sheet)

Correspondence regarding this well should be addressed to B - H - P
Address P. O. Box 62, Great Bend, Kansas

STATE OF KANSAS, COUNTY OF BARTON, ss.
Leon F. Huff, Partner of B - H - P, (owner or operator) of the above-described well, being first duly sworn on oath, says: That I have knowledge of the facts, statements, and matters herein contained and the log of the above-described well as filed and that the same are true and correct. So help me God.

(Signature) Leon F. Huff
P. O. Box 62, Great Bend, Kansas
(Address)

SUBSCRIBED AND SWORN TO before me this 24th day of November, 19 50
Mildred Hobbie
Notary Public.

My commission expires March 6, 1954.

28-3278-s 4-50-10M

PLUGGING
FILE SEC 7 T 9 R 186
BOOK PAGE 144 LINE 24

15-163-19282-00-00

DRILLER'S LOG

OPERATOR: B - H - P LOCATION: GEL NW/4 NE/4
 FARM NAME: Werner Section 7-9S-18W
 WELL NUMBER: One Rocks County, Kansas

CONTRACTOR: B - H - P CASING RECORD:
 8-5/8" @ 200', cemented
 w/125 sacks cement and
 1 sack calcium chloride

ROTARY COMMENCED: November 11, 1950
 ROTARY COMPLETED: November 21, 1950

ELEVATION: 2039' D.F. INITIAL POTENTIAL: Dry and Abandoned

Figures Denote Bottoms of Formations

Post Rock and Shale	75		
Shale	170		
Shale and Red Bed	200		
Shale and Shells	1455		<u>TOPS</u>
Anhydrite	1490	Anhydrite	1455
Shale and Shells	1725	Hebner	3183
Salt, Shale and Shells	1935	Lansing-Kansas City	3223
Lime and Shale	2235	Erosional Arbuckle	3477
Broken Lime	2325		
Lime	2395		
Broken Lime	2550		
Lime	2730		
Lime and Shale	3015		
Lime	3425		
Lime and Conglomerate	3465		
Lime and Chert	3559		
Conglomerate and Chert	3621		
Total Depth Rotary			

STATE OF KANSAS))
)) SS
 BARTON COUNTY))

I hereby certify that the foregoing is, to the best of my knowledge and belief, a full, true and correct drilling log as shown by the daily drilling reports in connection with the aforesaid well.

Leon F. Huff

 Leon F. Huff,
 Partner of B - H - P
 STATE CORPORATION

Subscribed and sworn to before me, the undersigned, a Notary Public, this 24th day of November, 1950.

NOV 25 1950
 CON. OF BARTON DIVISION
 Wichita, Kansas

Mildred G. Hobbs

 Notary Public

My commission expires March 6, 1954.

PLUGGING
 FILE SEC 7 T 9 R 18 W
 BLOCK PAGE 44 LINE 74