


STATE OF KANSAS  
STATE CORPORATION COMMISSION

Form CP-4

Give All Information Completely  
Make Required Affidavit  
Mail or Deliver Report to:  
Conservation Division  
State Corporation Commission  
212 No. Market  
Wichita, Kansas

WELL PLUGGING RECORD

Rooks County. Sec. 7 Twp. 19 Rge. 9 (X) 18 (W)  
Location as "NE/CNW/SW" or footage from lines SW NE SW  
Lease Owner Union Texas Petroleum  
Lease Name Cabbage Well No. 4  
Office Address 1740 Broadway, Denver, Colorado  
Character of Well (completed as Oil, Gas or Dry Hole) oil  
Date well completed \_\_\_\_\_ 19\_\_\_\_  
Application for plugging filed \_\_\_\_\_ 19\_\_\_\_  
Application for plugging approved May 19 19 67  
Plugging commenced June 15 19 67  
Plugging completed June 15 19 67  
Reason for abandonment of well or producing formation depleted

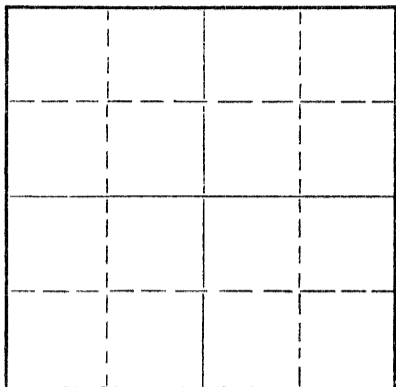

Locate well correctly on above  
Section Plat

If a producing well is abandoned, date of last production \_\_\_\_\_ 19\_\_\_\_  
Was permission obtained from the Conservation Division or its agents before plugging was commenced? yes

Name of Conservation Agent who supervised plugging of this well Leo Massey  
Producing formation \_\_\_\_\_ Depth to top \_\_\_\_\_ Bottom \_\_\_\_\_ Total Depth of Well 3497' Feet  
Show depth and thickness of all water, oil and gas formations.

OIL, GAS OR WATER RECORDS

CASING RECORD

FORMATION	CONTENT	FROM	TO	SIZE	PUT IN	PULLED OUT
				10-3/4"	197'	none
				5-1/2"	3487'	none

Describe in detail the manner in which the well was plugged, indicating where the mud fluid was placed and the method or methods used in introducing it into the hole. If cement or other plugs were used, state the character of same and depth placed, from \_\_\_\_\_ feet to \_\_\_\_\_ feet for each plug set.

3497' = 480' pumped 25 sacks gel mud and 3 sacks of hulls.  
480' - base pumped 60 sacks cement

RECEIVED  
STATE CORPORATION COMMISSION  
JUL 5 1967  
CONSERVATION DIVISION  
Wichita, Kansas

(If additional description is necessary, use BACK of this sheet)

Name of Plugging Contractor Santa-Fe Pipe & Supply, Inc.,  
Address P. O. Box 562, Great Bend, Kansas

STATE OF KANSAS, COUNTY OF BARTON, ss.  
T. L. Nutt

(employee of owner) or (owner or operator) of the above-described well, being first duly sworn on oath, says: That I have knowledge of the facts, statements, and matters herein contained and the log of the above-described well as filed and that the same are true and correct. So help me God.

(Signature) T. L. Nutt  
P. O. Box 562, Great Bend, Kansas  
(Address)

SUBSCRIBED AND SWORN TO before me this 30 day of June, 1967

My commission expires July 31, 1970  
Mary M. Guesnier  
Notary Public.

WELL LOG BUREAU - KANSAS GEOLOGICAL SOCIETY  
412 Union National Bk. Bldg., Wichita, Kansas

**COPY**


15-163-02287-00-00

Company - H H AND B DRILLING COMPANY, INC.  
Farm - Cabbage No. 4

SEC. 7 T. 9 R. 18W  
SW NE SW

Total Depth. 3497'  
Comm. 5-7-47 Comp. 5-17-47  
Shot or Treated.  
Contractor. H H & B Drilling Co., Inc.  
Issued. 7-19-47

County. Rocks  
KANSAS

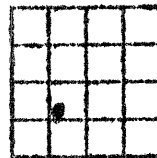

Elevation. \_\_\_\_\_

Production. Pot. 297 bbls oil

**CASING:**

10-3/4" 197' Com. w/125 sx  
6-1/2" OD 3487' Com. w/150 sx

Figures Indicate Bottom of Formations.

clay and sand	0-70
shale & sand	210
shale	730
sand	1110
shale	1140
shale, shells & sand	1428
anhydrite	1470
lime, shale & shells	1685
shale	1875
lime & shale	2005
lime	2105
shale & lime	3165
lime Arbuckle	3490
lime	3497
Total Depth	

Tops:	
Anhydrite	1428
Heebner	3206
Lansing	3246
Arbuckle	3486

**RECEIVED**  
STATE CORPORATION COMMISSION  
5/22/67  
MAY 22 1967

CONSERVATION DIVISION  
Wichita, Kansas