


15-163-20926-00-00

Give All Information Completely
Make Required Affidavit
Mail or Deliver Report to:
Conservation Division
State Corporation Commission
212 North Market, Insurance Bldg.
Wichita, Kansas

WELL PLUGGING RECORD

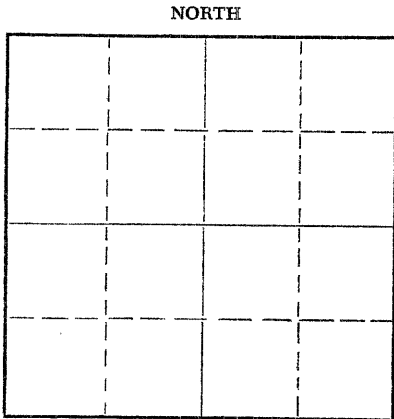

Locate well correctly on above Section Plat

Rooks County, Sec. 7 Twp. 9 Rge. 18W (E) (W)
Location as "NE/CNW%SW%" or footage from lines SW NE SE
Lease Owner Hellar Drilling Company, Inc.
Lease Name Cabbage Well No. 1
Office Address 1014 Union Center
Character of Well (completed as Oil, Gas or Dry Hole) Dry Hole
Date well completed 9-8 19 59
Application for plugging filed 9-8 19 59
Application for plugging approved 9-8 19 59
Plugging commenced 9-8 19 59
Plugging completed 9-8 19 59
Reason for abandonment of well or producing formation Dry Hole

If a producing well is abandoned, date of last production _____ 19____
Was permission obtained from the Conservation Division or its agents before plugging was commenced? Yes, Orally

Name of Conservation Agent who supervised plugging of this well Eldon Petty
Producing formation _____ Depth to top _____ Bottom _____ Total Depth of Well 3559 Feet
Show depth and thickness of all water, oil and gas formations.


OIL, GAS OR WATER RECORDS

CASING RECORD

FORMATION	CONTENT	FROM	TO	SIZE	PUT IN	PULLED OUT
		0	200	8-5/8"	203'	None

Describe in detail the manner in which the well was plugged, indicating where the mud fluid was placed and the method or methods used in introducing it into the hole. If cement or other plugs were used, state the character of same and depth placed, from _____ feet to _____ feet for each plug set.

Filled hole with mud to 550' set 1st plug with 20 sacks cement. Set 2nd plug at 180' with 15 sacks cement. Set 3rd plug at 40' to bottom of cellar with 10 sacks cement.

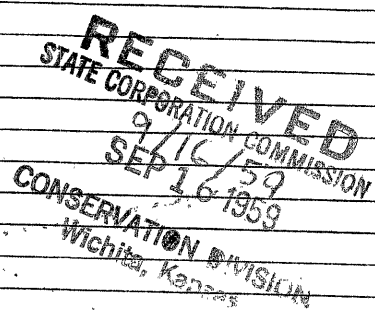

(If additional description is necessary, use BACK of this sheet)
Name of Plugging Contractor Hellar Drilling Company, Inc.
Address 1014 Union Center

STATE OF KANSAS, COUNTY OF SEDGWICK, ss.
D. L. Hellar (employee of owner) ~~or (owner or operator)~~ of the above-described well, being first duly sworn on oath, says: That I have knowledge of the facts, statements, and matters herein contained and the log of the above-described well as filed and that the same are true and correct. So help me God.
(Signature) D. L. Hellar
1014 Union Center
(Address)

SUBSCRIBED AND SWORN TO before me this 8th day of September, 19 59
Wanda Lou Bues
Notary Public.

My commission expires March 6, 1961.

PLUGGING
File Sec. 7 T 9 R 18W
Book Page 3 Line 27

15-163-00928-00-00

WELL LOG

OWNER:	Hellar Drilling Company, Inc.
LEASE:	#1 Cabbage
LOCATION:	SW NE SE, SEC. 7-9S-18W Rooks County, Kansas
COMMENCED:	September 1, 1959
COMPLETED:	September 8, 1959
CASING:	8-5/8" set at 200' w/125 sacks cement

0 - 200	Shale & sand
200 - 275	Shale
275 - 950	Shale & Streaks of sand
950 - 1150	Sand
1150 - 1467	Shale & red beds
1467 - 1505	Anhydrite
1505 - 1950	Shale & lime
1950 - 2385	Ft. Riley lime
2385 - 2600	Shale & chlkly lime
2600 - 2935	Shale & lime
2935 - 3130	Lime & shale
3130 - 3202	Lansing Kansas-City
3202 - 3548	Lime
3548 - 3559	Conglomerate
	Rotary Total Depth
	D & A

RECEIVED
STATE CORPORATION COMMISSION
SEP 16 1959
CONSERVATION DIVISION
Wichita, Kansas

STATE OF KANSAS)
COUNTY OF SEDGWICK) SS

I, D. L. Hellar, do hereby certify that the above and foregoing is a true and correct copy of the log of the CABBAGE #1, located in the SW NE SE, of Section 7-9S-18W, Rooks County, Kansas, as reflected by the files of the HELLAR DRILLING COMPANY, INC.

HELLAR DRILLING COMPANY, INC.

BY *D. L. Hellar*
D. L. Hellar, President

Subscribed and sworn to before me, a Notary Public, in and for Sedgwick County, Kansas, this 8th day of September, 1959.

Wanda Lou Bruce
Notary Public

My commission expires March 6, 1961.

PLUGGING
File No. 7-9-18W
Sheet Page 3 Line 27