


15-163-20625-00-00

STATE OF KANSAS
STATE CORPORATION COMMISSION

WELL PLUGGING RECORD

Give All Information Completely
Make Required Affidavit
Mail or Deliver Report to
Conservation Division
State Corporation Comm.
245 North Water
Wichita, KS 67202

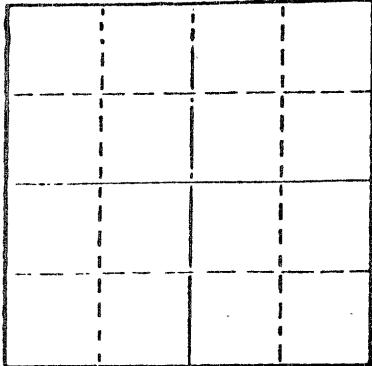

Locate well correctly on above
Section Plot

Rooks _____ County. Sec. 28 Twp. 9 Rge. 18 W E/W
Location as "NE/CNW $\frac{1}{4}$ SW $\frac{1}{4}$ " or footage from lines _____
C N/2 NE/4
Lease Owner R & R Oil
Lease Name Rempe Well No. 6
Office Addressc/o Dick Green, Box 503, Hays, Kansas 67601
Character of Well (Completed as Oil, Gas or Dry Hole) _____

Dry Hole
Date Well completed Aug 1 19 76
Application for plugging filed Aug 1 19 76
Application for plugging approved Aug 1 19 76
Plugging commenced Aug 1 19 76
Plugging completed Aug 1 19 76

Reason for abandonment of well or producing formation _____
Dry Hole
If a producing well is abandoned, date of last production 19 _____

Was permission obtained from the Conservation Division or
its agents before plugging was commenced? yes

Name of Conservation Agent who supervised plugging of this well Leo Massey
Producing formation _____ Depth to top _____ Bottom _____ Total Depth of Well 3614
Show depth and thickness of all water, oil and gas formations.

OIL, GAS OR WATER RECORDS

CASING RECORD

FORMATION	CONTENT	FROM	TO	SIZE	PUT IN	PULLED OUT

Describe in detail the manner in which the well was plugged, indicating where the mud fluid
was placed and the method or methods used in introducing it into the hold. If cement or other
plugs were used, state the character of same and depth placed, from _____ feet to
_____ feet for each plug set.

Hole full of heavy mud to 600' w/70 sacks cement thru drill pipe. received
Mud to 250' w/20 sacks cement thru drill pipe.
Mud to 40' w/ $\frac{1}{2}$ sack hulls plug & 10 sacks cement.
2 sacks cement in rat hole.

Conservation Division
Wichita, Kansas

(If additional description is necessary, use BACK of this sheet)
Name of Plugging Contractor Duke Drilling Co.

STATE OF KANSAS COUNTY OF BARTON, ss.
Larry Curtis (employee of owner) or (owner or operator)
of the above-described well, being first duly sworn on oath, says: That I have knowledge of
the facts, statements, and matters herein contained and the log of the above-described well
as filed and that the same are true and correct. So help me God.

(Signature) Larry Curtis
Box 823, Great Bend, Kansas 67530
(Address)

SUBSCRIBED AND SWORN TO before me this 2nd day of August, 19 76

My commission expires April 11, 1978
Notary Public.

15-163-20625-00-00

DRILLERS' WELL LOG

DATE COMMENCED: July 26, 1976
 DATE COMPLETED: August 1, 1976

R & R Oil
 REMPE # 6
 C N/2 NE/4
 Sec 28-T9-R18W
 Rocks County, Kansas

ELEVATION: 2164, K.B.

0 - 225'	Clay and Shale
225 - 1485'	Shale and Sand
1485 - 1524'	Anhydrite
1524 - 2075'	Shale
2075 - 3093'	Shale and Lime
3093 - 3306'	Lime
3306 - 3310'	Shale
3310 - 3327'	Lime and Shale
3327 - 3348'	Lime
3348 - 3575'	Lime
3575 - 3614'	Lime, Shale, Chert
3614'	RTD

FORMATION TOPS

Anhydrite	1485
Topeka	3093
Heebner	3306
Toronto	3327
Lansing K.C.	3348
Base K.C.	3575
RTD	3614

SURFACE PIPE:

Set used 8 5/8", 28# pipe
 @ 225' w/140 sacks Common,
 2% Gal, 3% cc.

REC'D
 8/5/76

AFFIDAVIT

STATE OF KANSAS }
 COUNTY OF BARTON } ss.

Larry Curtis, of lawful age, does swear and state that the facts and statements herein contained are true and correct to the best of his knowledge.

Larry Curtis

Subscribed and sworn to before me this 3rd day of August, 1976.

Clarence M. Hogue
 Notary Public

My Commission Expires: April 11, 1978