

ATTESTED

COPY

Frank Broadfoot

October 4, 1976


Form CP-4

STATE OF KANSAS
STATE CORPORATION COMMISSION

Give All Information Completely
Make Required Affidavit
Mail or Deliver Report to:
Conservation Division
State Corporation Commission

P. O. Box 17027
Wichita, Kansas 67217
NORTH

WELL PLUGGING RECORD

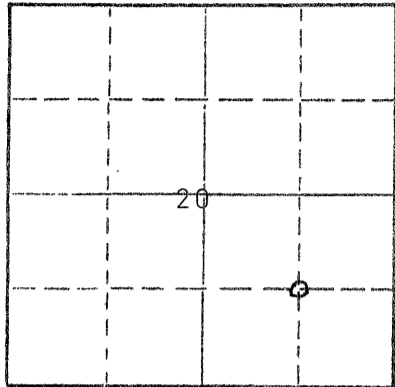

Locate well correctly on above
Section Plat

ROOKS County. Sec. 20 Twp. 9 Rge. 18 (E) West
Location as "NE/CNW/SW" or footage from lines C SE/4
Lease Owner C-G DRILLING CO.
Lease Name BAUMGARTNER Well No. 1
Office Address 1107 UNION NATIONAL BUILDING, WICHITA, KS.
Character of Well (completed as Oil, Gas or Dry Hole) PRODUCING - OIL
Date well completed SEPT. 29 1976
Application for plugging filed YES - MARCH 23 1976
Application for plugging approved YES - MARCH 23 1976
Plugging commenced JUNE 10 1976
Plugging completed JUNE 10 1976
Reason for abandonment of well or producing formation PLUGGED & ABANDONED

If a producing well is abandoned, date of last production JULY 1973
Was permission obtained from the Conservation Division or its agents before plugging was commenced? YES

Name of Conservation Agent who supervised plugging of this well LEO F MASSEY
Producing formation ARBUCKLE Depth to top Bottom Total Depth of Well 3582 Feet
Show depth and thickness of all water, oil and gas formations.

OIL, GAS OR WATER RECORDS

CASING RECORD

FORMATION	CONTENT	FROM	TO	SIZE	PUT IN	PULLED OUT
				8 5/8	175'	NONE

Describe in detail the manner in which the well was plugged, indicating where the mud fluid was placed and the method or methods used in introducing it into the hole. If cement or other plugs were used, state the character of same and depth placed, from feet to feet for each plug set.

RAN 30 SACKS CEMENT + 4% GEL.
1 SACK HULLS + 30 SACKS GEL.
RELEASE PLUG AND PUMPED 70
SACKS COMMON CEMENT + 4% GEL.
@ 1:45 PM CEMENT HELD.

RECEIVED
STATE CORPORATION COMMISSION

OCT 04 1976

10-4-76
CONSERVATION DIVISION
Wichita, Kansas


Name of Plugging Contractor SUN OILWELL CEMENTING CO.
Address GREAT BEND, KANSAS 67530

STATE OF KANSAS, COUNTY OF SEDGWICK, ss.
G. F. Galloway

(employee or owner) or (owner or operator) of the above-described well, being first duly sworn on oath, says: That I have knowledge of the facts, statements, and matters herein contained and the log of the above-described well as filed and that the same are true and correct. So help me God.

(Signature)

G. F. Galloway
1107 Union National Bldg. Wichita 67202

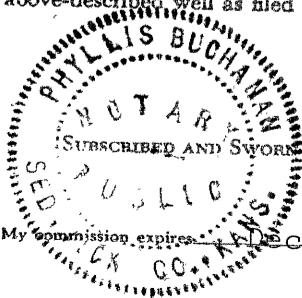

Subscribed and sworn to before me this 1st day of October, 1976

Phyllis Buchanan
Phyllis Buchanan
Notary Public.

W E L L L O G

OPERATOR C-G Drilling Co. & Houston Petroleum Co. SEC. 20-9-18W
 WELL NAME Baumgartner #1 LOC. C SE/4
 TOTAL DEPTH 3582' COUNTY Rooks
 COMM. September 22, 1959 COMP. September 29, 1959 STATE Kansas
 RIG NO. 1 ELEVATION 2168' R.B.
 CASING: Ran 175' (8 jts.) 8-5/8" OD Surface PRODUCTION: Producing
 Casing.
 Set 5-1/2" OD Casing @3577' (112 jts.)

All measurements taken from the top of rotary bushing.

FROM	TO	FORMATION	DEVIATION FROM VERTICAL	REMARKS:
0	495	Shale-Shell		
495	840	Streak Sand-Shale		
840	970	Sand		
970	1100	Shale-Sand		
1100	1498	Shale		
1498	1540	Anhydrite		
1540	1555	Shale		
1555	2010	Shale-Shell		
2010	2135	Shale-Lime		
2135	2335	Lime-Shale		
2335	2580	Lime-Shale	0° - 2500	
2580	2715	Lime	0° - 2750	
2715	3227	Lime-Shale	0° - 3000	
3227	3290	Shale-Lime	0° - 3250	
3290	3575	Lime		
3575	3582	Arbuckle		DST 3577-3582'

RECEIVED
 STATE CORPORATION COMMISSION
 OCT 04 1976
 10-4-76
 CONSERVATION DIVISION
 Wichita, Kansas

STATE OF KANSAS)
 COUNTY OF SEDGWICK) SS.

The undersigned hereby certifies that to the best of his knowledge and belief, the above facts are true and correct.

C-G DRILLING CO.

By G. F. Galloway
 G. F. Galloway

SUBSCRIBED AND SWORN TO, BEFORE ME, THIS 6th day of October, 1959.

My commission expires:
 May 20, 1963

Vicky Jacobs
 Vicky Jacobs - Notary public