

STATE OF KANSAS
STATE CORPORATION COMMISSION


Give All Information Completely
Make Required Affidavit
Mail or Deliver Report to:
Conservation Division
State Corporation Commission
211 No. Broadway
Wichita, Kansas

WELL PLUGGING RECORD

Rooks County, Sec. 20 Twp. 9 Rge. 18 (E) (W) W

Location as "NE/CNW/SW" or footage from lines SE NE SE
Lease Owner C-G Drilling Co. & Houston Petroleum Co.
Lease Name Baumgartner Well No. 2
Office Address 107 Rule Building, Wichita 2, Kansas
Character of Well (completed as Oil, Gas or Dry Hole) Dry Hole
Date well completed December 18 1959
Application for plugging filed December 18 1959
Application for plugging approved December 18 1959
Plugging commenced December 18 1959
Plugging completed December 18 1959
Reason for abandonment of well or producing formation Too low structurally

NORTH

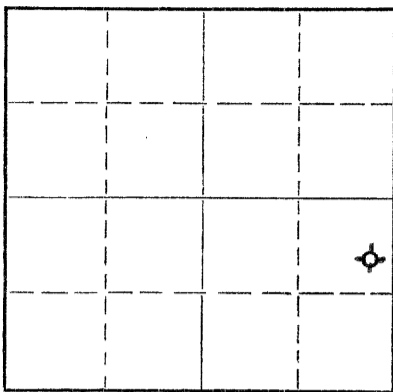

Locate well correctly on above
Section Plat

If a producing well is abandoned, date of last production _____ 19____
Was permission obtained from the Conservation Division or its agents before plugging was commenced? Yes

Name of Conservation Agent who supervised plugging of this well Eldon Petty, Hays, Kansas
Producing formation _____ Depth to top _____ Bottom _____ Total Depth of Well 3610' Feet
Show depth and thickness of all water, oil and gas formations.


OIL, GAS OR WATER RECORDS

CASING RECORD

FORMATION	CONTENT	FROM	TO	SIZE	PUT IN	PULLED OUT
				8-5/8"	160'	None

Describe in detail the manner in which the well was plugged, indicating where the mud fluid was placed and the method or methods used in introducing it into the hole. If cement or other plugs were used, state the character of same and depth placed, from _____ feet to _____ feet for each plug set.

Filled hole with heavy mud to 540'. Set plug. Put in 20 sacks cement. Filled to 150'. Set plug. Put in 1/2 sack hulls and 15 sacks cement. Filled with heavy mud up to 40'. Set plug. Filled to top with 1/2 sack hulls and 10 sacks cement.

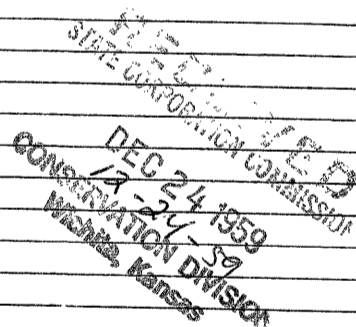

(If additional description is necessary, use BACK of this sheet)
Name of Plugging Contractor C-G Drilling Co.
Address 107 Rule Building, Wichita 2, Kansas

STATE OF KANSAS COUNTY OF SEDGWICK, ss.
G. F. Galloway (employee of owner) or (owner or operator) of the above-described well, being first duly sworn on oath, says: That I have knowledge of the facts, statements, and matters herein contained and the log of the above-described well as filed and that the same are true and correct. So help me God.

(Signature) G. F. Galloway
107 Rule Building (Address)

SUBSCRIBED AND SWORN TO before me this 21st day of December, 1959

My commission expires May 20, 1963
Vicky Jacobs Notary Public.



W E L L L O G

OPERATOR C-G Drilling Co. & Houston SEC. 20-9-18W
 Petroleum Co.
 WELL NAME Baumgartner #2 LOC. SE NE SE
 TOTAL DEPTH 3610' COUNTY Rooks
 COMM. December 12, 1959 COMP. December 18, 1959 STATE Kansas
 RIG NO. 2 ELEVATION 2169' R.B.
 CASING: Ran 160' 8-5/8" OD Surface Casing. PRODUCTION: D&A

All measurements taken from the top of rotary bushing.

FROM	TO	FORMATION	DEVIATION FROM VERTICAL	REMARKS:
0	3120	This well was drilled by Heathman-Seeligson to a total depth of 3120'. We washed this well down to 3120' and subsequently drilled to 3610'.		
3120	3585	Lime	0° - 3500	DST 3587-3590'
3585	3610	Arubckle		DST 3590-3595' DST 3595-3600' DST 3600-3610'

RECEIVED
 STATE CORPORATION COMMISSION
 DEC 24 1959
 12-24-59
 CONSERVATION DIVISION
 Wichita, Kansas

STATE OF KANSAS }
 COUNTY OF SEDGWICK } SS.

The undersigned hereby certifies that to the best of his knowledge and belief, the above facts are true and correct.

C-G DRILLING CO.

By G. F. Galloway
 G. F. Galloway

SUBSCRIBED AND SWORN TO, BEFORE ME, THIS 21st day of December, 1959.

My commission expires:
 May 20, 1963

Vicky Jacobs
 Vicky Jacobs - Notary public