

CARD MUST BE TYPED

State of Kansas
NOTICE OF INTENTION TO DRILL
(see rules on reverse side)

CARD MUST BE SIGNED

Starting Date: 06/07/85
month day year

API Number 15- 037-21, 335-00-00

OPERATOR: License # 6001

C. N/2 SW. SW. Sec 26 . Twp .28 . S, Rge 21. . East
(location) West

Name Robert E. Austin

Address P.O. Box 1406

City/State/Zip Miami, OK 74355

Contact Person Max Alcock

Phone 316-431-4267

... 990..... Ft North from Southeast Corner of Section

.. 4620..... Ft West from Southeast Corner of Section

(Note: Locate well on Section Plat on reverse side)

CONTRACTOR: License # 5667

Name Howard Lavery

City/State Chanute, Kansas

Nearest lease or unit boundary line 660..... feet.

County Crawford

Lease Name Fox, A..... Well# 4-WI.....

Domestic well within 330 feet : yes no

Municipal well within one mile : yes no

Well Drilled For: Well Class: Type Equipment:

- Oil Swd Infield Mud Rotary
- Gas Inj Pool Ext. Air Rotary
- OWWO Expl Wildcat Cable

If OWWO: old well info as follows:

Operator

Well Name

Comp Date Old Total Depth

Projected Total Depth 450..... feet

Projected Formation at TD Bartlesville

Expected Producing Formations Cattleman

Depth to Bottom of fresh water feet

Lowest usable water formation

Depth to Bottom of usable water 100..... feet

Surface pipe by Alternate : 1 2

Surface pipe to be set 20..... feet

Conductor pipe if any required

Ground surface elevation feet MSL

This Authorization Expires 11-30-85

Approved By 5-30-85 [Signature]

I certify that we will comply with K.S.A. 55-101, et seq., plus eventually plugging hole to K.C.C. specifications.

Date .. 5/25/85 Signature of Operator or Agent [Signature] Title Operator

RCH for KDHE


Must be filed with the K.C.C. five (5) days prior to commencing well
This card void if drilling not started within six (6) months of date received by K.C.C.

5-30-85

RECEIVED
STATE CORPORATION COMMISSION

Important procedures to follow MAY 30 1985

A Regular Section of Land
1 Mile = 5,280 Ft.

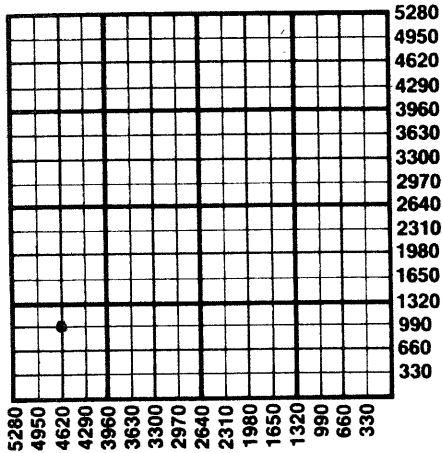

1. Notify District office before setting surface casing
2. Set surface casing by circulating cement to the top.
3. File completion forms ACO-1 with K.C.C. within 90 days of well completion, following instructions on ACO-1, side 1, and including copies of wireline logs.
4. Notify District office 48 hours prior to old well workover or re-entry.
5. Prior to plugging, prepare a plugging plan, then obtain agreement from the appropriate district office for an approved plugging plan.
6. Submit plugging report (CP-4) to K.C.C. after plugging is completed.
7. Obtain an approved injection docket number before disposing of salt water.
8. Notify K.C.C. within 10 days when injection commences or terminates.
9. If an alternate 2 completion, cement in the production pipe from below any usable water to surface within 120 days of spud date.

CONSERVATION DIVISION
Wichita, Kansas

State Corporation Commission of Kansas
Conservation Division
200 Colorado Derby Building
Wichita, Kansas 67202
(316) 263-3238