

CARD MUST BE TYPED

State of Kansas

CARD MUST BE SIGNED

# NOTICE OF INTENTION TO DRILL

(see rules on reverse side)

Starting Date September 27, 1985  
month day year 3:45

API Number 15— 037-21,366-0000

OPERATOR: License # 9418  
Name Bonanza Energy Corporation  
Address P.O. Box A  
City/State/Zip Benedict, KS 66714  
Contact Person Douglas Lamb  
Phone (316) 698-2495

app. X East  
SE SE SW Sec. 26. Twp. 28. S, Rg. 21. West  
545 Ft. from South Line of Section  
2670 Ft. from East Line of Section

(Note: Locate well on Section Plat on reverse side)

CONTRACTOR: License #  
Name Company Tools  
City/State

Nearest lease or unit boundary line 545 feet  
County Crawford  
Lease Name Little Well # 10-A  
Ground surface elevation na feet MSL

Well Drilled For: Well Class: Type Equipment:  
X Oil SWD X Infield X Mud Rotary  
Gas Inj Pool Ext. Air Rotary  
OWWO Expl Wildcat Cable

Domestic well within 330 feet: yes X no  
Municipal well within one mile: yes X no  
Surface pipe by Alternate: 1 2 X  
Depth to bottom of fresh water 20  
Depth to bottom of usable water 100  
Surface pipe planned to be set 20  
Projected Total Depth 450 feet  
Formation Bartlesville

If OWWO: old well info as follows:

Operator  
Well Name  
Comp Date Old Total Depth

I certify that well will comply with K.S.A. 55-101, et seq., plus eventually plugging hole to KCC specifications.

                     cementing will be done immediately upon setting production casing.  
Date 9/26/85 Signature of Operator or Agent Susan Arnold Title As Agent

For KCC Use:

Conductor Pipe Required                      feet; Minimum Surface Pipe Required                      feet per 1 2  
This Authorization Expires 3-26-86 Approved By                      9-26-85


Must be filed with the K.C.C. five (5) days prior to commencing well  
This card void if drilling not started within six (6) months of date received by K.C.C.

RECEIVED  
STATE CORPORATION COMMISSION

9-26-85

SEP 26 1985

A Regular Section of Land CONSERVATION DIVISION  
1 Mile = 5,280 Ft. Wichita, Kansas

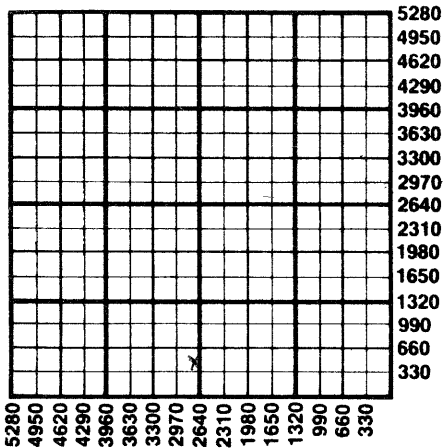

Important procedures to follow:

1. Notify District office before setting surface casing.
2. Set surface casing by circulating cement to the top.
3. File completion forms ACO-1 with K.C.C. within 90 days of well completion, following instructions on ACO-1, side 1, and including copies of wireline logs.
4. Notify District office 48 hours prior to old well workover or re-entry.
5. Prior to filing Intent, prepare a proposed plugging plan in case well is D & A, then obtain approval of plan when calling district office prior to setting surface pipe.
6. Submit plugging report (CP-4) to K.C.C. after plugging is completed.
7. Obtain an approved injection docket number before disposing of salt water.
8. Notify K.C.C. within 10 days when injection commences or terminates.
9. If an alternate 2 completion, cement in the production pipe from below any usable water to surface within 120 days of spud date.

State Corporation Commission of Kansas  
Conservation Division  
200 Colorado Derby Building  
Wichita, Kansas 67202  
(316) 263-3238