

CARD MUST BE TYPED

State of Kansas

CARD MUST BE SIGNED

NOTICE OF INTENTION TO DRILL

(see rules on reverse side)

Starting Date September 20, 1987
month day year

API Number 15-207-251534-0000

OPERATOR: License # 7162

SW Sec. 34 Twp. 26 S, Rg. 16 East
_____ West

Name B. W. Klippel, Jr.

1190 Ft. from South Line of Section

Address 401 South Fry Street

3575 Ft. from East Line of Section

City/State/Zip Yates Center, Kansas 66783

(Note: Locate well on Section Plat on reverse side)

Contact Person B. W. Klippel, Jr.

Nearest lease or unit boundary line 1762 feet

Phone 316-625-2329

County Woodson

CONTRACTOR: License # To be determined

Lease Name Apt #1A #1 Well # I-33

Name _____

Ground surface elevation 996± feet MSL

City/State _____

Domestic well within 330 feet: _____yes Xno

Well Drilled For: Well Class: Type Equipment:

Municipal well within one mile: _____yes Xno

___ Oil X SWD X Infield ___ Mud Rotary

Depth to bottom of fresh water No fresh water

___ Gas X Inj ___ Pool Ext. ___ Air Rotary

Depth to bottom of usable water No useable water 250

___ OWWO ___ Expl ___ Wildcat ___ Cable

Surface pipe by Alternate: _____ 1-2 X

IF OWWO: old well info as follows:

Surface pipe planned to be set 40' of 6-1/4"

Operator _____

Conductor pipe required No

Well Name _____

Projected Total Depth 1030 feet

Comp Date _____ Old Total Depth _____

Formation Lower Cattleman ss.

I certify that well will comply with K.S.A. 55-101, et seq., plus eventually plugging hole to KCC specifications.

Date 9-9-87 Signature of Operator or Agent _____ Title Operator

For KCC Use:

Conductor Pipe Required _____ feet; Minimum Surface Pipe Required 40 feet per Alt. X 2


This Authorization Expires 3-23-88 Effective 9-28-87 Approved By 924923-87

Must be filed with the K.C.C. five (5) days prior to commencing well
This card void if drilling not started within six (6) months of date received by K.C.C.

Important procedures to follow:

1. Notify District office before setting surface casing.
2. Set surface casing by circulating cement to the top.
3. File completion forms ACO-1 with K.C.C. within 90 days of well completion, following instructions on ACO-1, side 1, and including copies of wireline logs.
4. Notify District office 48 hours prior to old well workover or re-entry.
5. Prior to filing Intent, prepare a proposed plugging plan in case well is D & A, then obtain approval of plan when calling district office prior to setting surface pipe.
6. Submit plugging report (CP-4) to K.C.C. after plugging is completed.
7. Obtain an approved injection docket number before disposing of salt water.
8. Notify K.C.C. within 10 days when injection commences or terminates.
9. If an alternate 2 completion, cement in the production pipe from below any usable water to surface within 120 days of spud date.

**A Regular Section of Land
1 Mile = 5,280 Ft.**

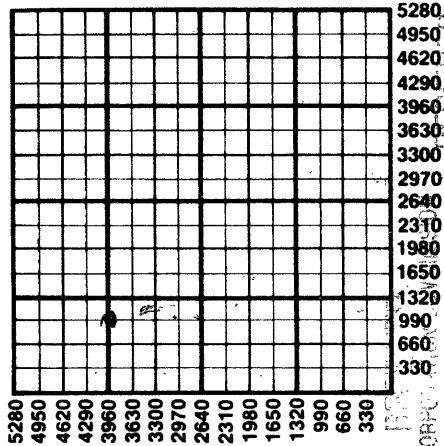

STATE CORPORATION COMMISSION

SEP 10 1987

CONSERVATION DIVISION
Wichita, Kansas

923-87

State Corporation Commission of Kansas
Conservation Division
200 Colorado Derby Building
Wichita, Kansas 67202
(316) 263-3238